Square Footage

Net Internal Area L-1(sqft) 7,058

Workplace Strategy

Collaboration Seats 42

Dedicated Workstations 56 (+58 day 2)

Enclosed Meeting Seats 39

Room Counts

WORKSPACE		
WORKSPACE	3	

RECEPTION

MEETING ROOM (14P)

MEETING ROOM MEETING ROOM (4P) MEETING ROOM (5P) MEETING ROOM (10P)

COMMUNAL

RECEPTION

TEA POINT **BREAK OUT** COLLOBORATION

STORAGE

CLEANERS CUPBOARD (KNOTEL) 1 STORAGE

PHONE BOOTHS


(1P) PHONE BOOTH (2P) PHONE BOOTH

IT/ COMMS

IT/ COMMS ROOM

TOILETS

FEMALE TOILET MALE TOILET

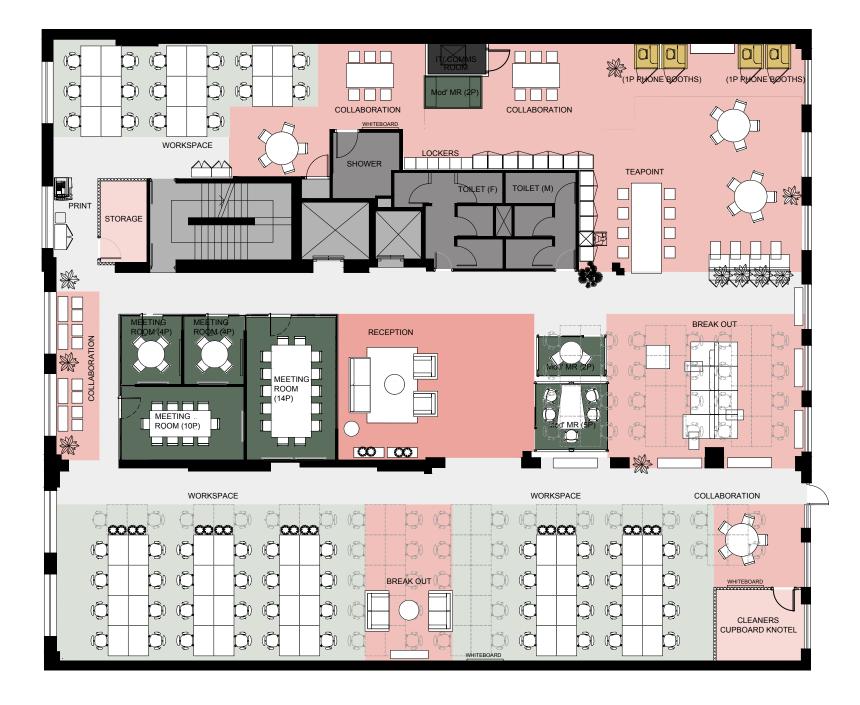

not be used, transferred, or disclosed to a third party without their express permission. No dimensions or other information should be inferred from the electronic copy unless specifically shown on the hard copy drawings or specifications. Do not scale from this drawings of specifications. Do not scale from this drawing. Figured dimensions only are to be used 'For Construction' and any scaling of the drawing will be at the Contractor's risk. Contractor to verify all dimensions, levels and components on-site. Any discrepancies shall be addressed in writing to Knotel Inc. for clarification prior do the commencement of the work, otherwise to Contractor shall bear the full responsibility for any associated cost. Any claims for variations or extras shall be submitted to Knotel Inc. for assessment prior to approval of any such variation or extra. This drawing is to be read in conjunction with all other contract

All designs are the sole property of Knotel Inc. and may

GENERAL NOTES

DAY 2 DESK

REVISIONS

NAME DATE COMMENTS

09 Dec 2022 AS BUILT

FLOORPLAN

PROPERTY ADDRESS Second Floor, 15 Hatfields, London, England SE1 8DJ

RENTABLE SIZE SCALE 7,058 Sqft 1:150 @A3 DRAWN BY CHECKED BY ΙB HT

FILE NAME

KNOTEL GENERAL ARRANGEMENT PLAN - LEVEL 2

LEGEND

Workspace

Reception

Meeting Room

Communal

Storage

Circulation

Phone Booths

Building Core

KNOTEL