

Square Footage

Net Internal Area L0(sqft) 272 SQM

Workplace Strategy


Collaboration Seats	16
Dedicated Workstations	24
Enclosed Meeting Seats	8

Room Counts

WORKSPACE	
WORKSPACE	1
MEETING ROOM	
MEETING ROOM (8P)	1
COMMUNAL	
TEA POINT	1
BREAK OUT	1
COLLOBORATION	1
PHONE BOOTHS	
(1P) PHONE BOOTH	2
IT/ COMMS	
IT/ COMMS ROOM	1
TOILETS	
TOILETS	4
STORAGE	
CLEANERS CUPBOARD	1
STORE ROOM	1

LEGEND

Workspace	Reception	Meeting Room	Communal	Wellness	Storage	Circulation	Phone Booths	IT/ Comms	Toilets	Building Core
-----------	-----------	--------------	----------	----------	---------	-------------	--------------	-----------	---------	---------------

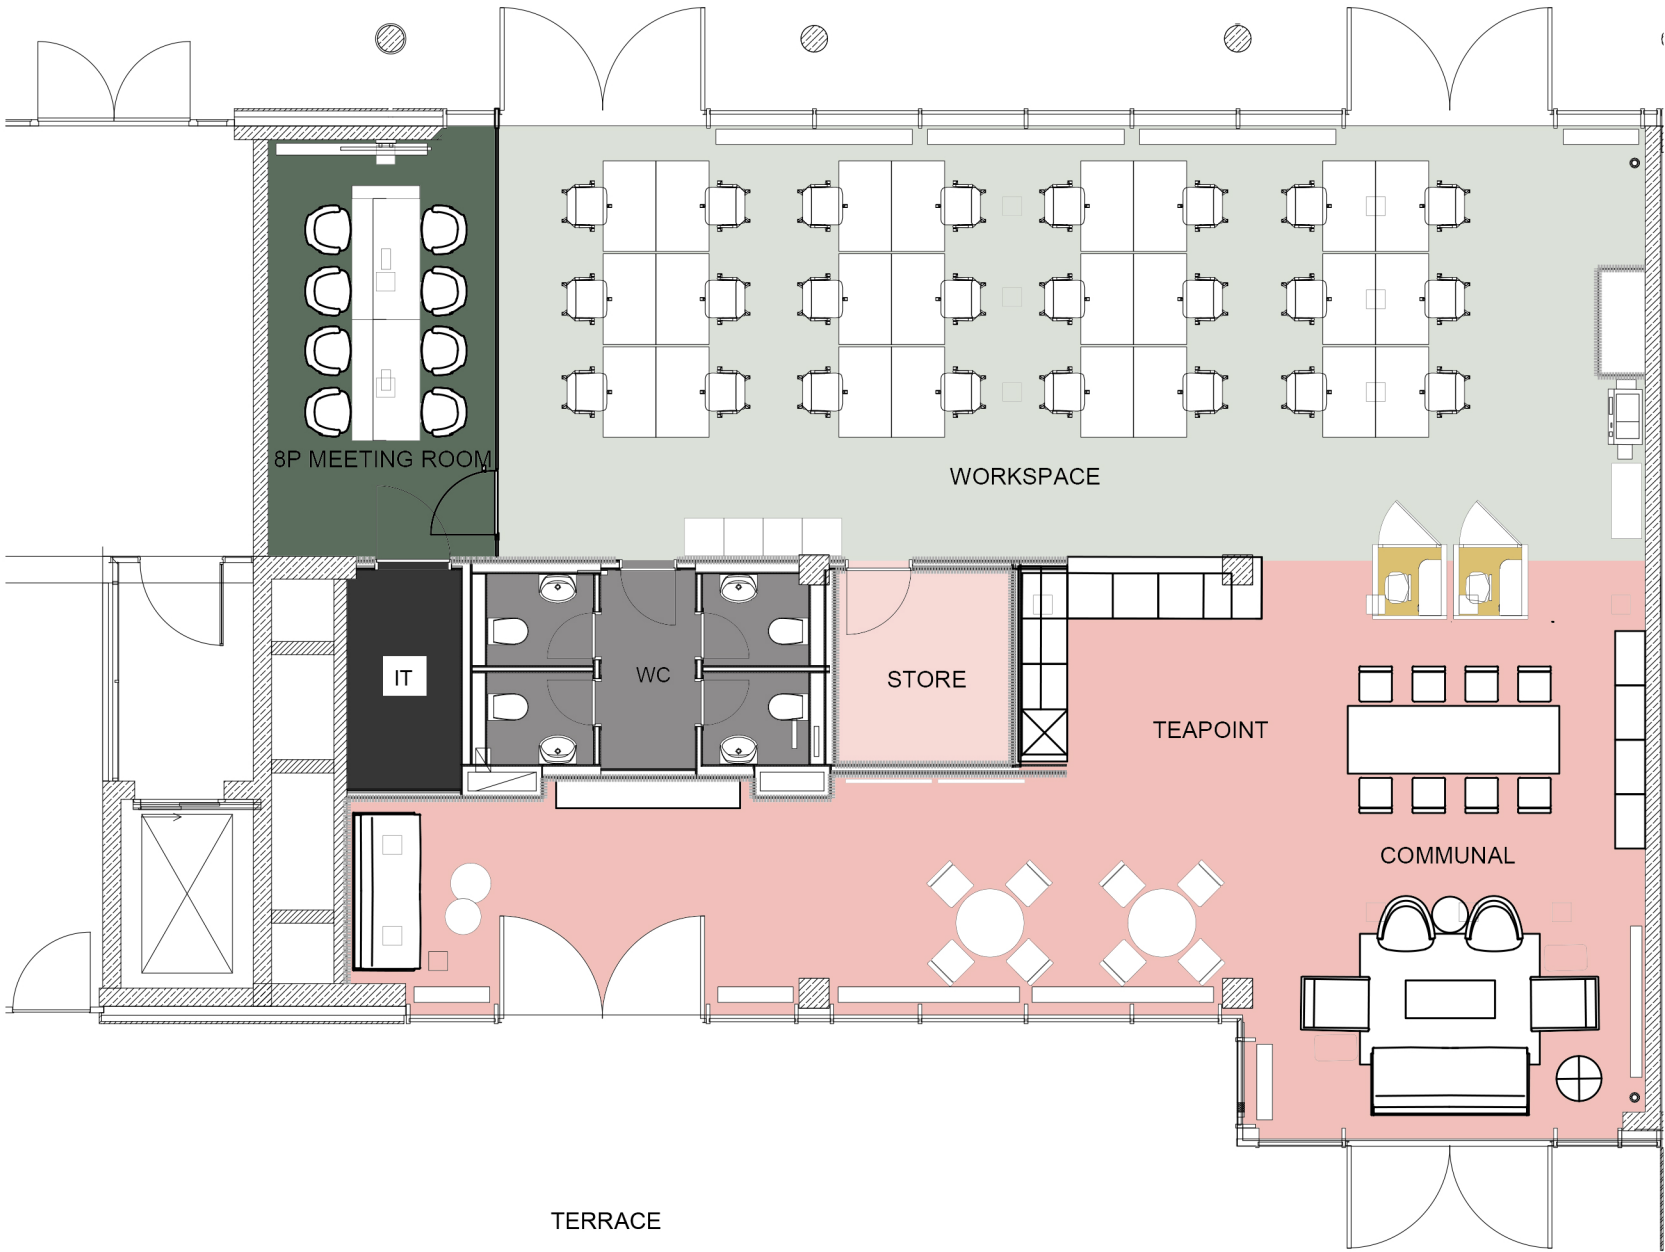

All designs are the sole property of Knotel Inc. and may not be used, transferred, or disclosed to a third party without their express permission. No dimensions or other information should be inferred from the electronic copy unless specifically shown on the hard copy drawings or specifications. Do not scale from this drawing. Figured dimensions only are to be used 'For Construction' and any scaling of the drawing will be at the Contractor's risk. Contractor to verify all dimensions, levels and components on-site. Any discrepancies shall be addressed in writing to Knotel Inc. for clarification prior do the commencement of the work, otherwise to Contractor shall bear the full responsibility for any associated cost. Any claims for variations or extras shall be submitted to Knotel Inc. for assessment prior to approval of any such variation or extra. This drawing is to be read in conjunction with all other contract documentation.

GENERAL NOTES



DAY 2 DESK

REVISIONS

ID	NAME	DATE	COMMENTS
01	EN	28 Feb 2023	AS BUILT

FLOORPLAN

PROPERTY ADDRESS
GROUND FLOOR, UNIT B
HUSSITENSTRASSE 32, BERLIN

RENTABLE SIZE 272 Sqm	SCALE 1:100 @A3
--------------------------	--------------------

DRAWN BY EN	CHECKED BY HT
----------------	------------------

FILE NAME
KNOTEL GENERAL ARRANGEMENT PLAN - LEVEL 0

KNOTEL