

IN THE HIGH COURT OF JUSTICE
KING'S BENCH DIVISION

BEFORE: THE HONOURABLE MR JUSTICE BOURNE

ON: 24 June 2025

B E T W E E N : -

(1) LONDON CITY AIRPORT LIMITED
(2) DOCKLANDS AVIATION GROUP LIMITED

-and-

**PERSONS UNKNOWN WHO, IN CONNECTION WITH THE JUST STOP OIL OR
OTHER ENVIRONMENTAL CAMPAIGN, ENTER OCCUPY OR REMAIN
(WITHOUT THE CLAIMANTS' CONSENT) UPON THAT AREA OF LAND
KNOWN AS LONDON CITY AIRPORT (AS SHOWN FOR IDENTIFICATION
EDGED RED ON THE ATTACHED PLAN 1) BUT EXCLUDING THOSE AREAS
OF LAND AS FURTHER DEFINED IN THE CLAIM FORM**



Defendants

ORDER

PENAL NOTICE

**IF YOU, THE DEFENDANTS, DISOBEY THIS ORDER OR INSTRUCT OR
ENCOURAGE OTHERS TO BREACH THIS ORDER YOU MAY BE HELD TO BE IN
CONTEMPT OF COURT AND MAY BE IMPRISONED, FINED OR HAVE YOUR
ASSETS SEIZED.**

**ANY OTHER PERSON WHO KNOWS OF THIS ORDER AND DOES ANYTHING
WHICH HELPS OR PERMITS THE DEFENDANTS OR ANY OF THEM TO
BREACH THE TERMS OF THIS ORDER MAY ALSO BE HELD TO BE IN
CONTEMPT OF COURT AND MAY BE IMPRISONED, FINED OR HAVE THEIR
ASSETS SEIZED.**

IMPORTANT NOTICE TO THE DEFENDANTS

**This Order prohibits you from doing certain acts. You should read this Order very
carefully. You are advised to consult a solicitor as soon as possible. You have the right to
apply to the court to vary or discharge this Order (which is explained below).**

UPON the injunction made by Order dated 20 June 2024 by Mr Justice Julian Knowles (“**the Knowles J Order**”)

AND UPON the Claimants’ application dated 2 June 2025

AND UPON the Claimants’ application dated 17 June 2025 to amend the claim form

AND UPON the review hearings in each of the following claims having been listed on 24 June 2025 to be heard together KB-2024-1765, KB-2024-002132, KB-2024-002317, and KB-2024-002473 (“**the Claims**”)

AND UPON reading the application and the witness evidence in support

AND UPON hearing Mr Morshead K.C. and Miss Barden, counsel for the Claimants and there being no other attendance

AND UPON the Court being satisfied that there has been no material change in circumstances warranting amendments to or the setting aside of the relief granted by the Knowles J Order

IT IS ORDERED that:

1. The Knowles J Order shall remain in full force and effect, subject to the variations thereto set out in the schedule to this order (and subject to review, as provided for in paragraph 3 of the Knowles J Order).
2. The Claimants have permission to amend the claim form to substitute the plan annexed to the Claimants’ application dated 17 June 2025 for Plan 1 to the claim form.
3. The court will provide sealed copies of this order to the Claimants’ solicitors for service or notification in accordance with paragraph 9 of the Knowles J Order.

Varied pursuant to the order of Bourne J dated 27 June 2025

IN THE HIGH COURT OF JUSTICE
KINGS BENCH DIVISION

CLAIM NO: KB-2024-001765

Before Mr Justice Julian Knowles
On 20 June 2024

BETWEEN:-

- (1) **LONDON CITY AIRPORT LIMITED**
(2) **DOCKLANDS AVIATION GROUP LIMITED**

Claimants

- v -

**PERSONS UNKNOWN WHO, IN CONNECTION WITH THE JUST STOP OIL OR
OTHER ENVIRONMENTAL CAMPAIGN, ENTER OCCUPY OR REMAIN (WITHOUT
THE CLAIMANTS' CONSENT) UPON THAT AREA OF LAND KNOWN AS LONDON
CITY AIRPORT (AS SHOWN FOR IDENTIFICATION EDGED RED ON THE
ATTACHED PLAN 1) BUT EXCLUDING THOSE AREAS OF LAND AS FURTHER
DEFINED IN THE CLAIM FORM**

Defendant

ORDER

PENAL NOTICE

**IF YOU THE WITHIN DEFENDANTS OR PERSONS UNKNOWN OR ANY OF YOU
DISOBEY THIS ORDER OR INSTRUCT OR ENCOURAGE OTHERS TO BREACH THIS
ORDER YOU MAY BE HELD TO BE IN CONTEMPT OF COURT AND MAY BE
IMPRISONED, FINED OR HAVE YOUR ASSETS SEIZED.**

**ANY OTHER PERSON WHO KNOWS OF THIS ORDER AND DOES ANYTHING WHICH
HELPS OR PERMITS THE DEFENDANTS OR PERSONS UNKNOWN TO BREACH THE
TERMS OF THIS ORDER MAY ALSO BE HELD IN CONTEMPT OF COURT AND MAY
BE IMPRISONED, FINED OR HAVE THEIR ASSETS SEIZED.**

IMPORTANT NOTICE TO THE DEFENDANTS AND PERSONS UNKNOWN

**This Order prohibits you from doing the acts set out in this Order. You should
read it very carefully. You are advised to consult a solicitor as soon as possible.
You have the right to ask the Court to vary or discharge this Order.**

UPON the Claimants' claim by Claim Form, dated 12 June 2024

AND UPON hearing the Claimants' application for an interim injunction, dated 12 June 2024, and supporting evidence, without Persons Unknown being notified

AND UPON hearing Counsel for the Claimants

AND UPON the Claimants giving and the Court accepting the undertakings set out in Schedule 2 to this Order

AND UPON the "Land" being defined as that land known as London City Airport, as shown for identification edged red on the attached Plan 1 in Schedule 1, but excluding:

- a. Those buildings shaded blue on Plan 1;
- b. In those buildings shaded green on Plan 1, the areas edged blue on Plans 2-8;
- c. In those areas shaded purple, the land suspended over the ground and forming part of the Docklands Light Railway.
- d. In the areas shaded pink, the underground rail tunnel, the subway and that part of Docklands Light Railway located below ground level.

IT IS ORDERED THAT: INJUNCTION

1. Until 20 June 2029 or final determination of the claim or further order in the meantime, whichever shall be the earlier, Persons Unknown must not, without the consent of the Claimants, enter, occupy or remain upon the Land.
2. In respect of paragraph 1, Persons Unknown must not: (a) do it himself/herself/themselves or in any other way; (b) do it by means of another person acting on his/her/their behalf, or acting on his/her/their instructions.
3. The injunction contained at paragraph 1 of this Order shall be reviewed on each anniversary of this Order (or as close to this date as is convenient having regard to the Court's list) ~~with a time estimate of 1.5 hours.~~ Such hearing shall be listed to be heard with the review of any injunctions made in all or any of the claims with case numbers KB-2024-002132, KB-2024-002317, and KB-2024-002473, with a time estimate of 1 day. The Claimants are permitted to file and serve any evidence in support 14 days before the review hearing. Skeleton arguments shall be filed at Court, with a bundle of authorities, not less than 2 days before the review hearing.

VARIATION

4. Anyone served with or notified of this Order may apply to the Court at any time to vary or discharge this Order or so much of it as affects that person but they must

first give the Claimants' solicitors 72 hours' notice of such application. If any evidence is to be relied upon in support of the application the substance of it must be communicated in writing to the Claimants' solicitors at least 48 hours in advance of any hearing.

5. Any person applying to vary or discharge this Order must provide their full name, address and address for service.
6. The Claimants have liberty to apply to vary this Order.

SERVICE AND NOTIFICATION

7. Service of the claim form, the application for interim injunction and this Order is dispensed with, pursuant to CPR 6.16, 6.28 and 81.4(2)(c).
8. Pursuant to the guidance in *Wolverhampton CC v London Gypsies & Travellers* [2024] 2 WLR 45, the Claim Form, Application Notice, evidence in support and Note of the Hearing on 20 June 2024 will be notified to Persons Unknown by the Claimants carrying out each of the following steps:
 - a. Uploading a copy onto the following website:
<https://www.londoncityairport.com/corporate/corporate-info/reports-and-publications/injunction>
 - b. Sending an email to the email addresses listed in Schedule 3 to this Order stating that a claim has been brought and an application made, and that the documents can be found at the website referred to above.
 - c. Either affixing a notice at those locations marked with an "X" on Plan 1 setting out where these documents can be found and obtained in hard copy or including this information in the warning notices referred to at paragraph 9(d) below.
9. Pursuant to the guidance in *Wolverhampton CC v London Gypsies and Travellers* [2024] 2 WLR 45, this Order shall be notified to Persons Unknown by the Claimants carrying out each of the following steps:

- a. Uploading a copy of the Order onto the following website:
<https://www.londoncityairport.com/corporate/corporate-info/reports-and-publications/injunction>
 - b. Sending an email to the email addresses listed in Schedule 3 to this Order attaching a copy of this Order.
 - c. Affixing a copy of the Order in A4 size in a clear plastic envelope at those locations marked with an "X" on Plan 1.
 - d. Affixing warning notices of A2 size at those locations marked with an "X" on Plan 1.
10. Pursuant to the guidance in *Wolverhampton CC v London Gypsies and Travellers* [2024] 2 WLR 45, notification to Persons Unknown of any further applications shall be effected by the Claimants carrying out each of the following steps:
 - a. Uploading a copy of the application onto the following website:
<https://www.londoncityairport.com/corporate/corporate-info/reports-and-publications/injunction>.
 - b. Sending an email to the email addresses listed in Schedule 3 to this Order stating that an application has been made and that the application documents can be found at the website referred to above.
 - c. Affixing a notice at those locations marked with an "X" on Plan 1 stating that the application has been made and where it can be accessed in hard copy and online.
11. Pursuant to the guidance in *Wolverhampton CC v London Gypsies and Travellers* [2024] 2 WLR 45, notification of any further documents to Persons Unknown may be effected by carrying out the steps set out in paragraph 10(a)-(b) only.
12. In respect of paragraphs 8 to 11 above, effective notification will be deemed to have taken place on the date on which all of the relevant steps have been carried out.
13. For the avoidance of doubt, in respect of the steps referred to at paragraphs 8(c), 9(c)-(d) and 10(c), effective notification will be deemed to have taken place when those documents are first affixed regardless of whether they are subsequently removed.

FURTHER DIRECTIONS

14. Liberty to apply.
15. Costs are reserved.

COMMUNICATIONS WITH THE CLAIMANT

16. The Claimants' solicitors and their contact details are:

(1) Stuart Wortley
Eversheds Sutherland (International) LLP
StuartWortley@eversheds-sutherland.com
07712 881 393

(2) Nawaaz Allybokus
Eversheds Sutherland (International) LLP
NawaazAllybokus@eversheds-sutherland.com
07920 590 944

Dated: 20 June 2024

SCHEDULE 1 - PLANS

Injunction



Excluded areas



Part excluded areas



Subsoil structures excluded




DLR viaduct excluded




Plan 1


Map scale 1:5,650


Assumes printed map area measures 395mm by 272mm.

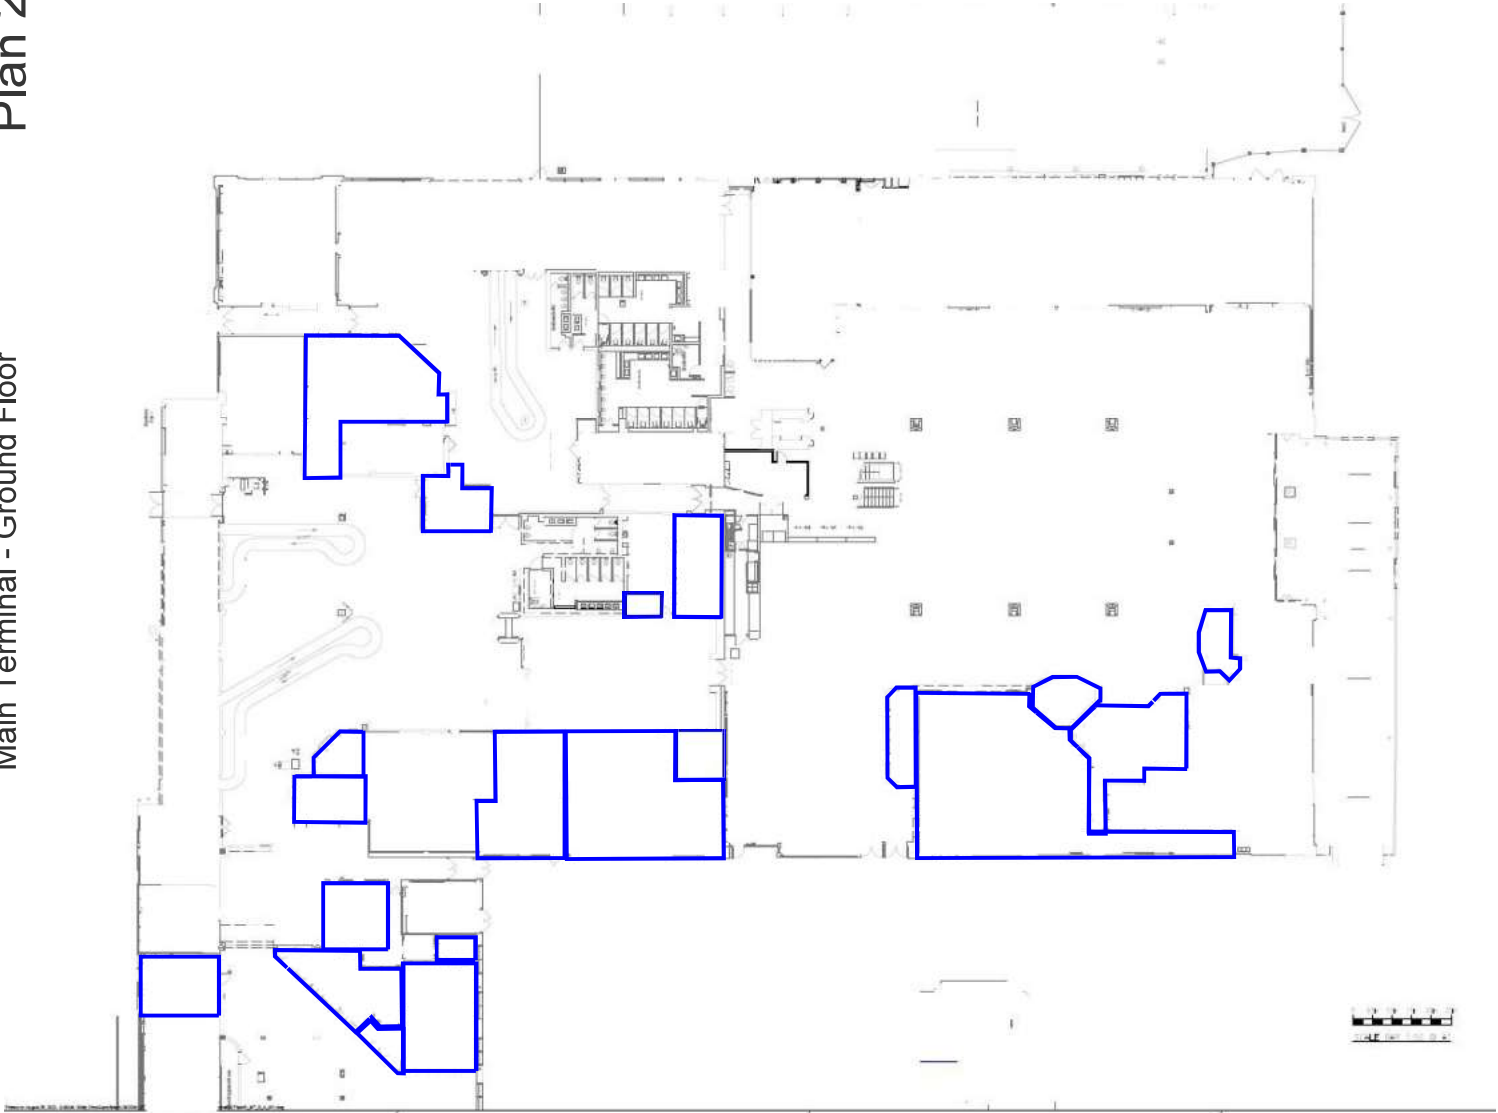

Plan 3

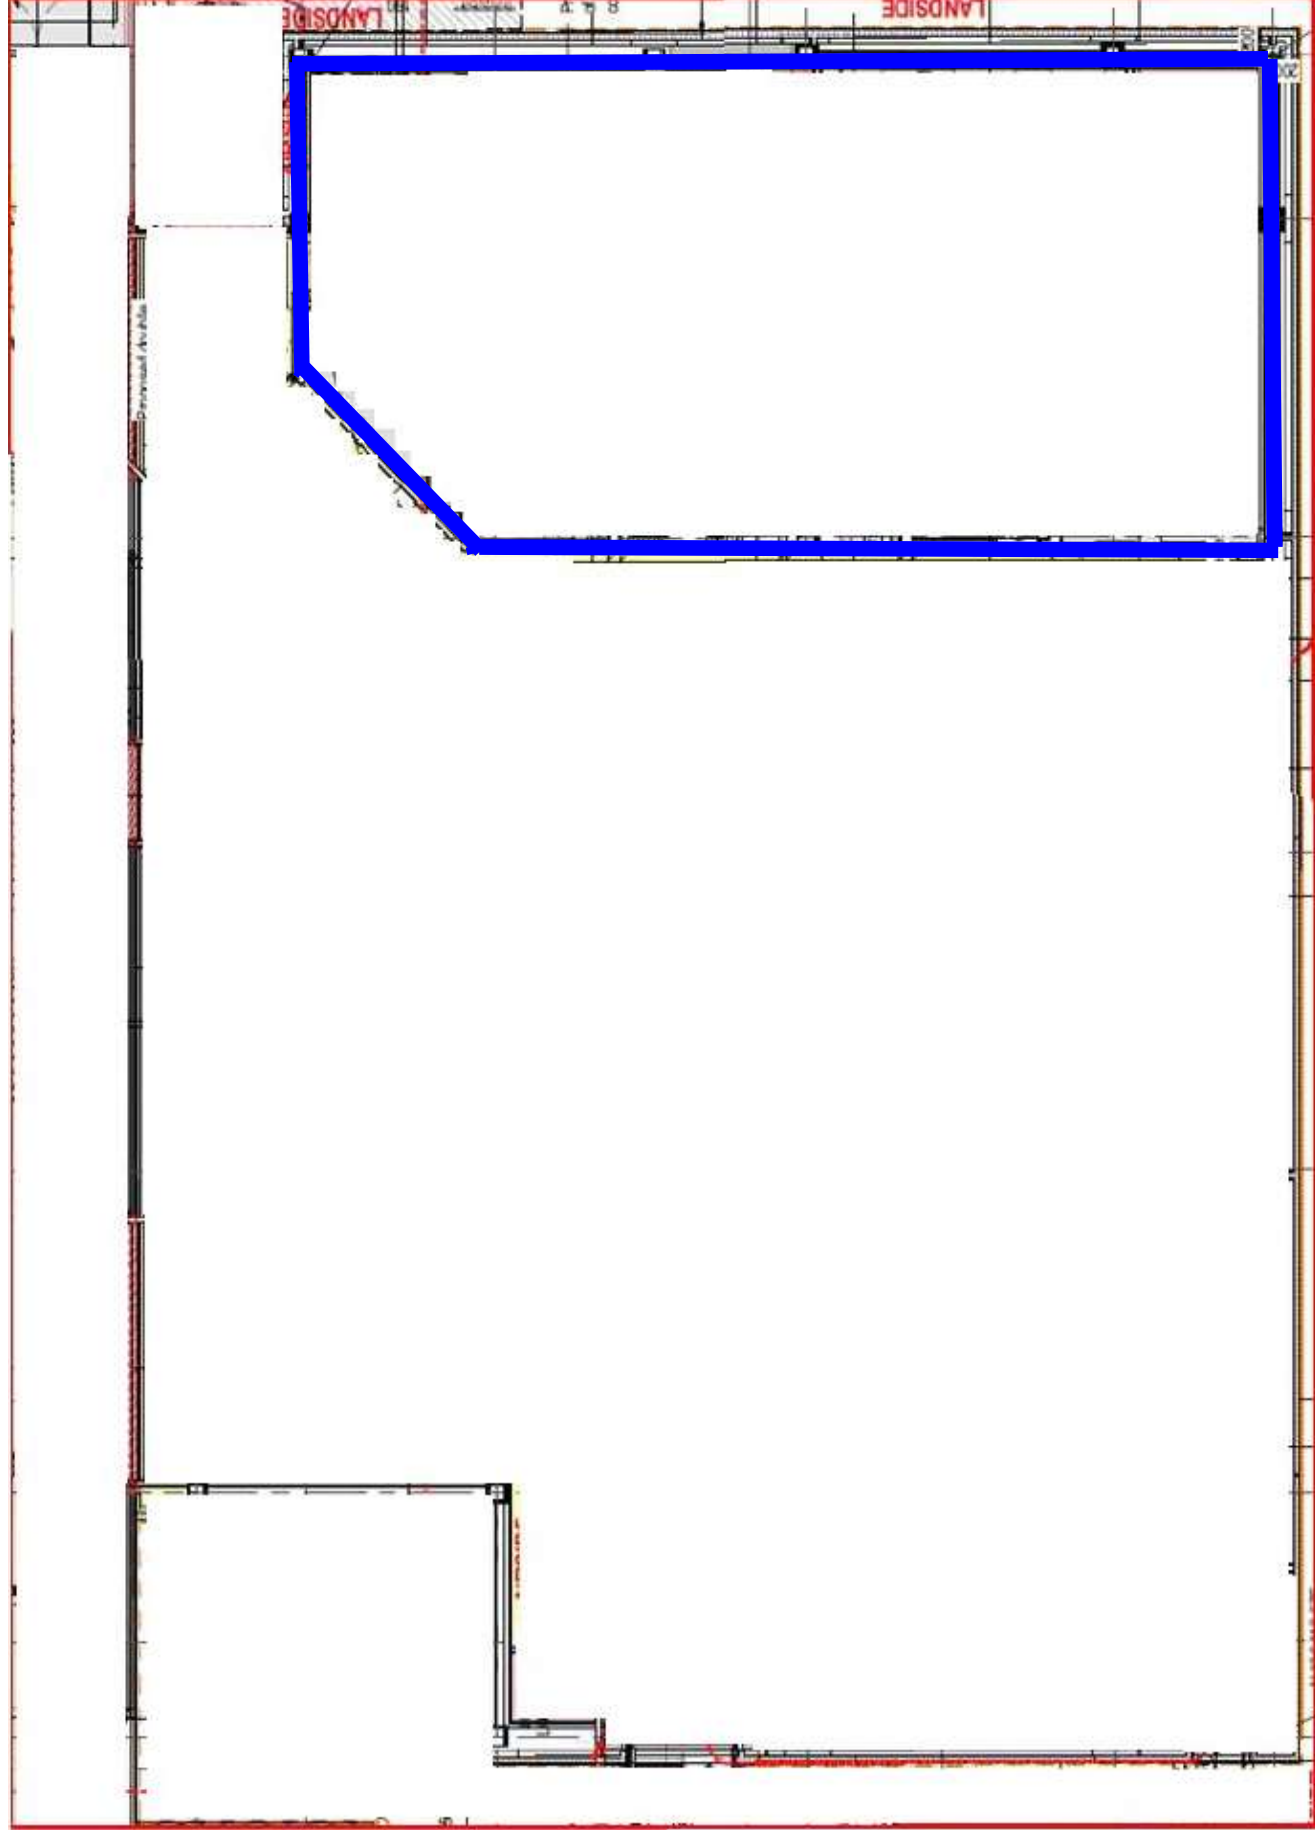

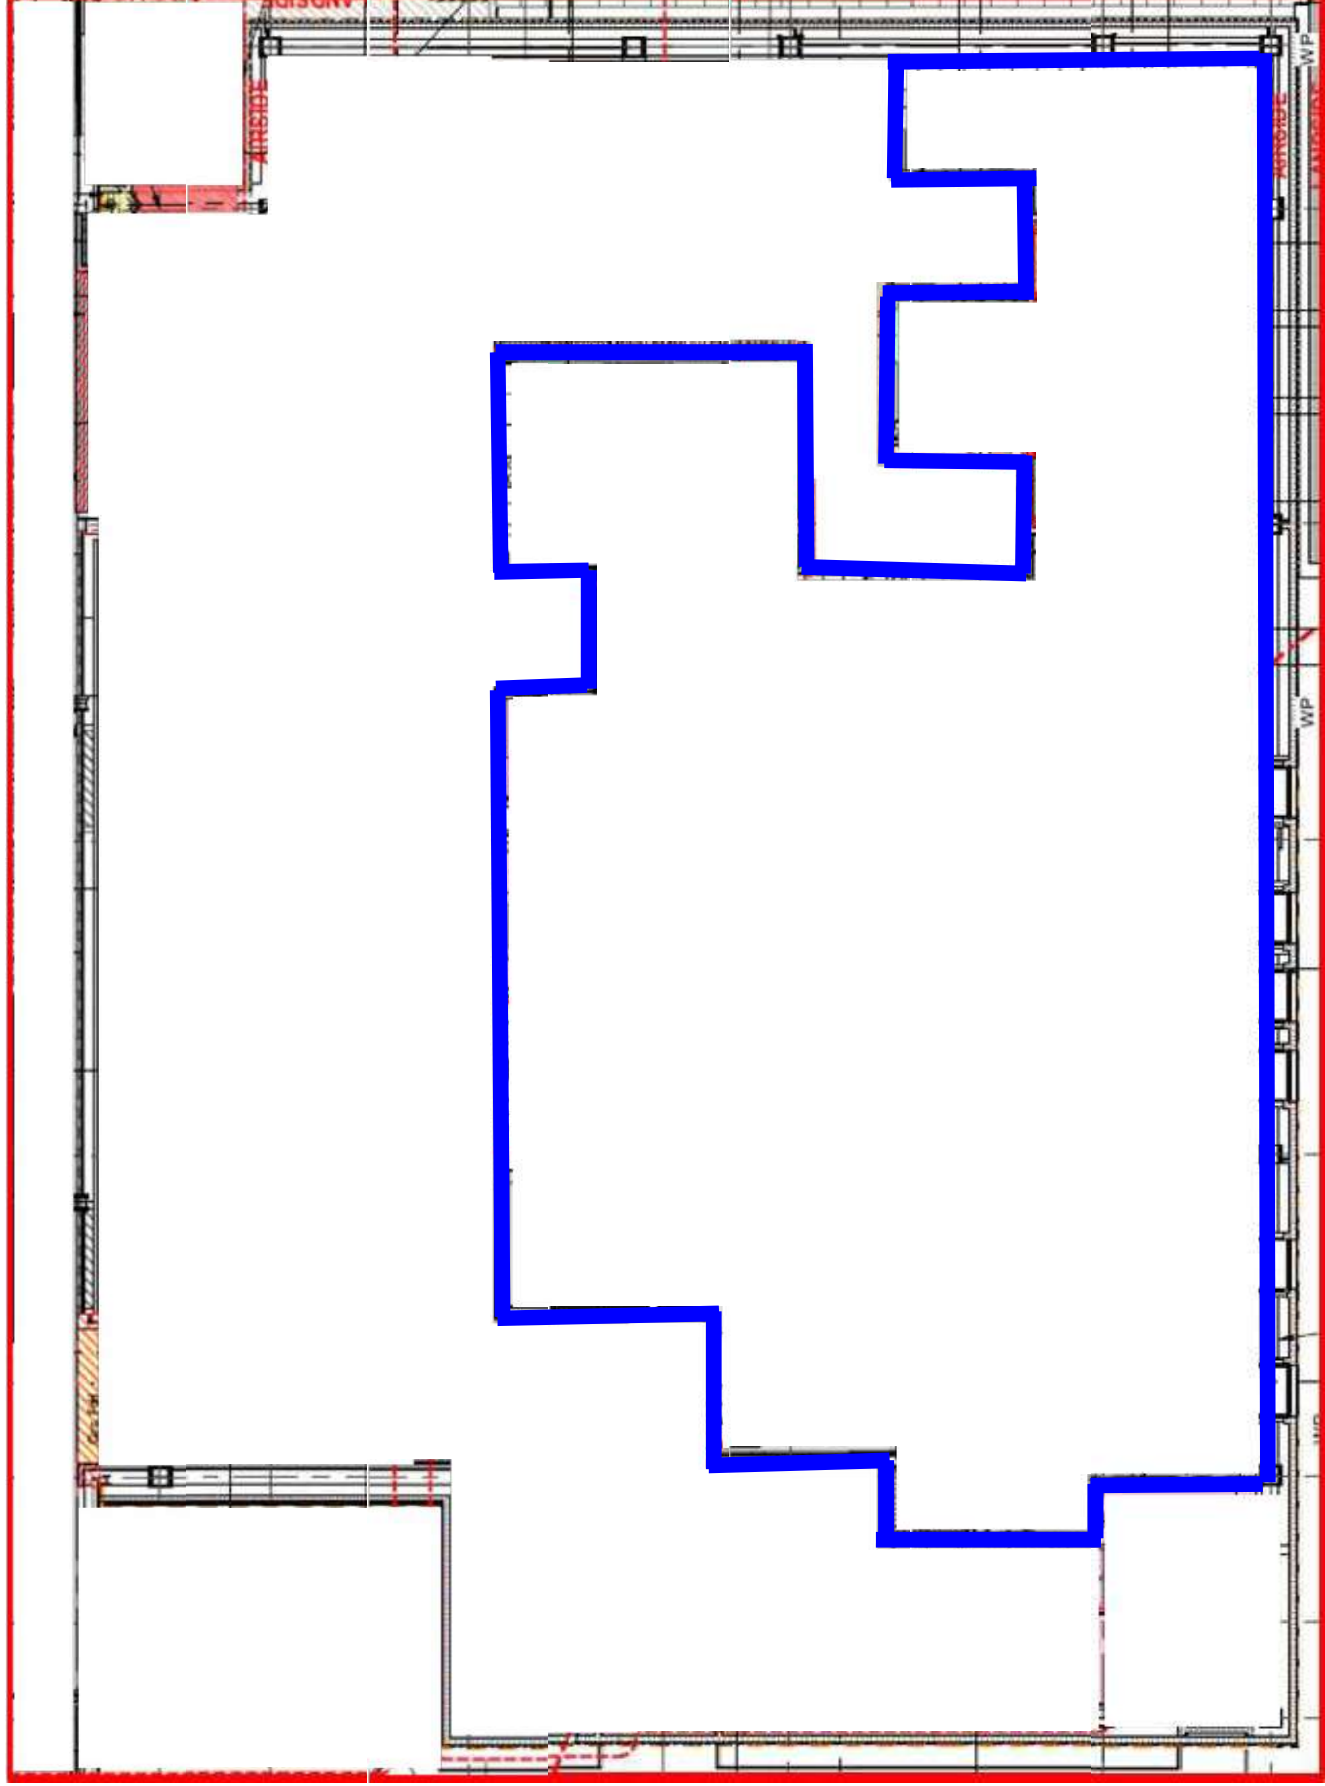

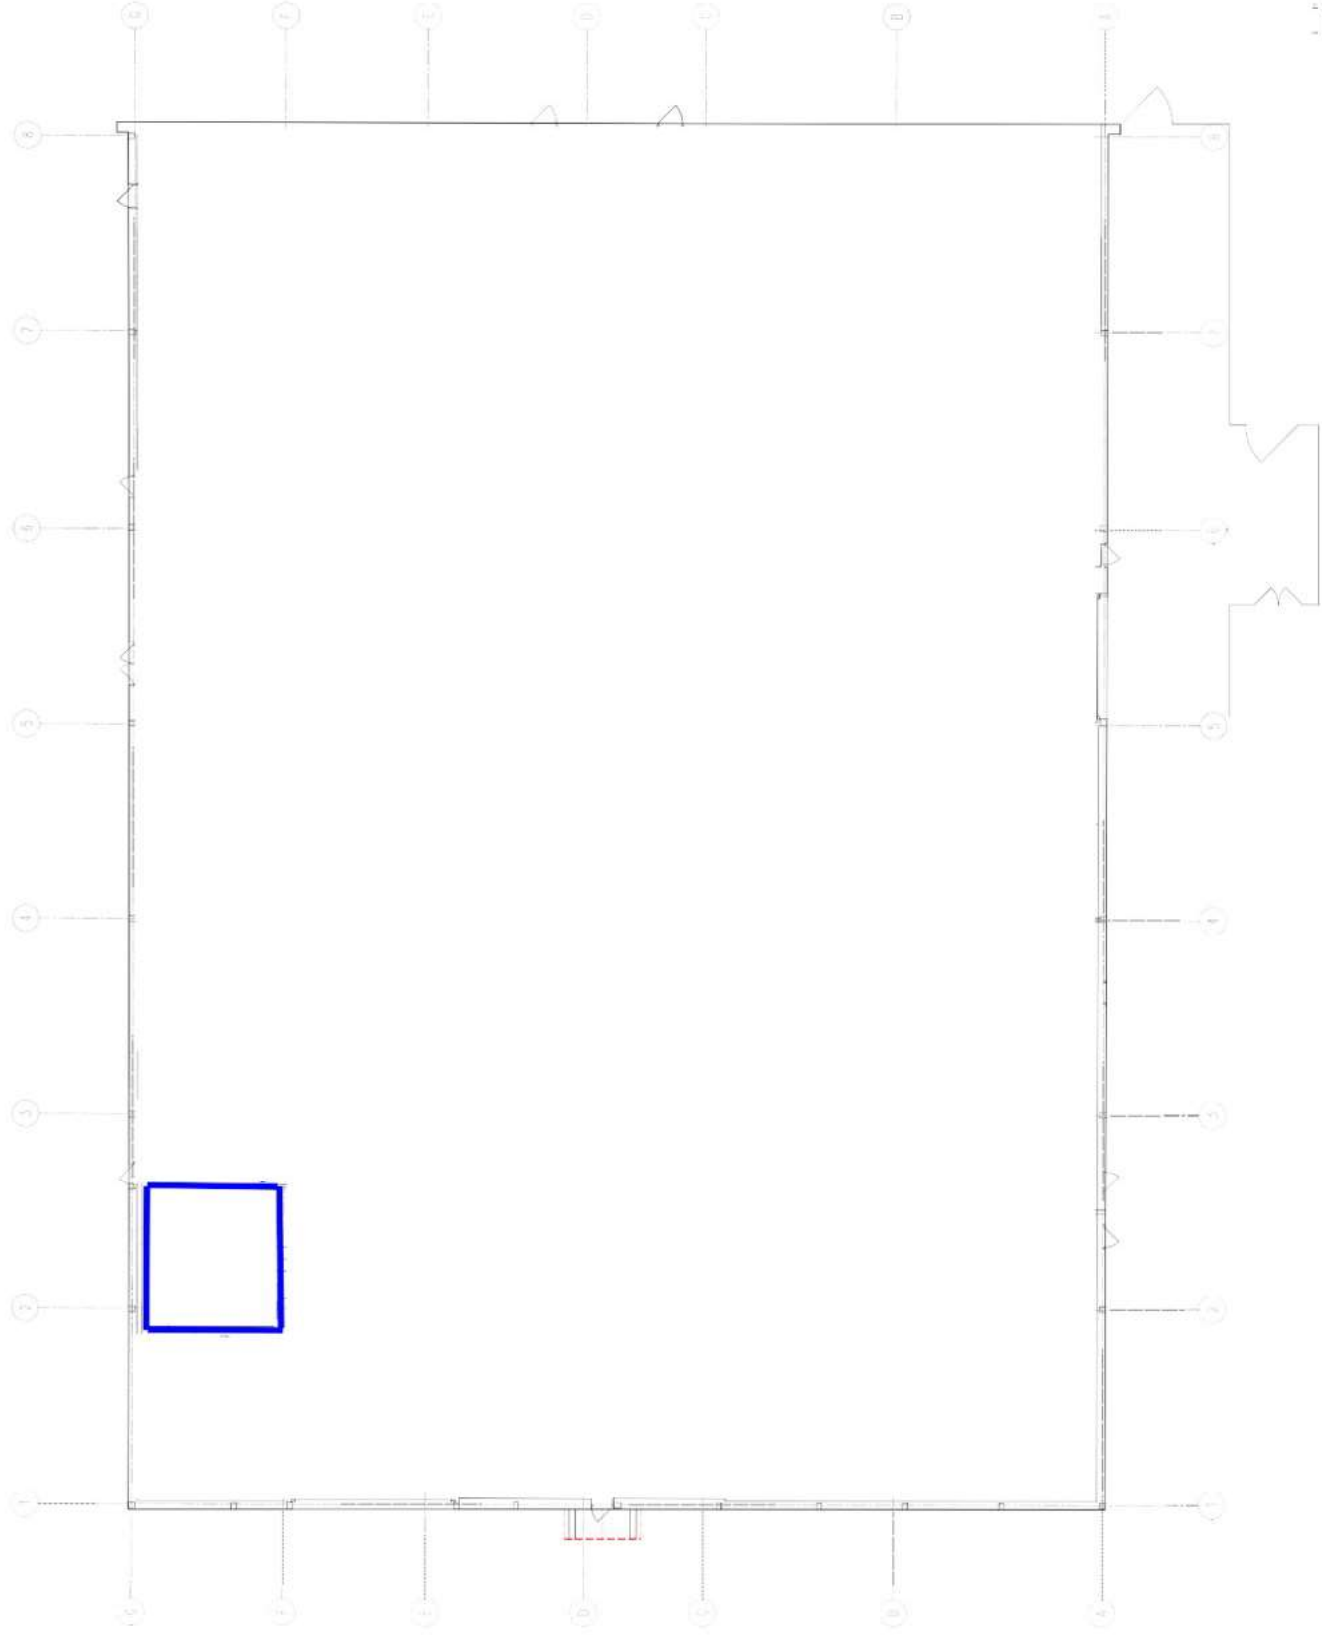

Blue Shed - First Floor

Plan 6

Structural Details

Use No

~~XXXX~~ FIRE DOOR
~~XXXX~~ STANDARD DOOR

1. Drawn by: [Name]	11/12/2018
2. Checked by: [Name]	11/12/2018



London City Airport
Gate 03/05
Address: London City Airport, 133, The Highway, London, E16 2AA, UK
Tel: 020 330 0000, 111 375

RECORD DRAWING

BLUE SHED



Drawn by: [Name]

Checked by: [Name]

11/12/2018


R/BS/1A/001

1/10

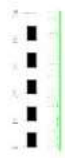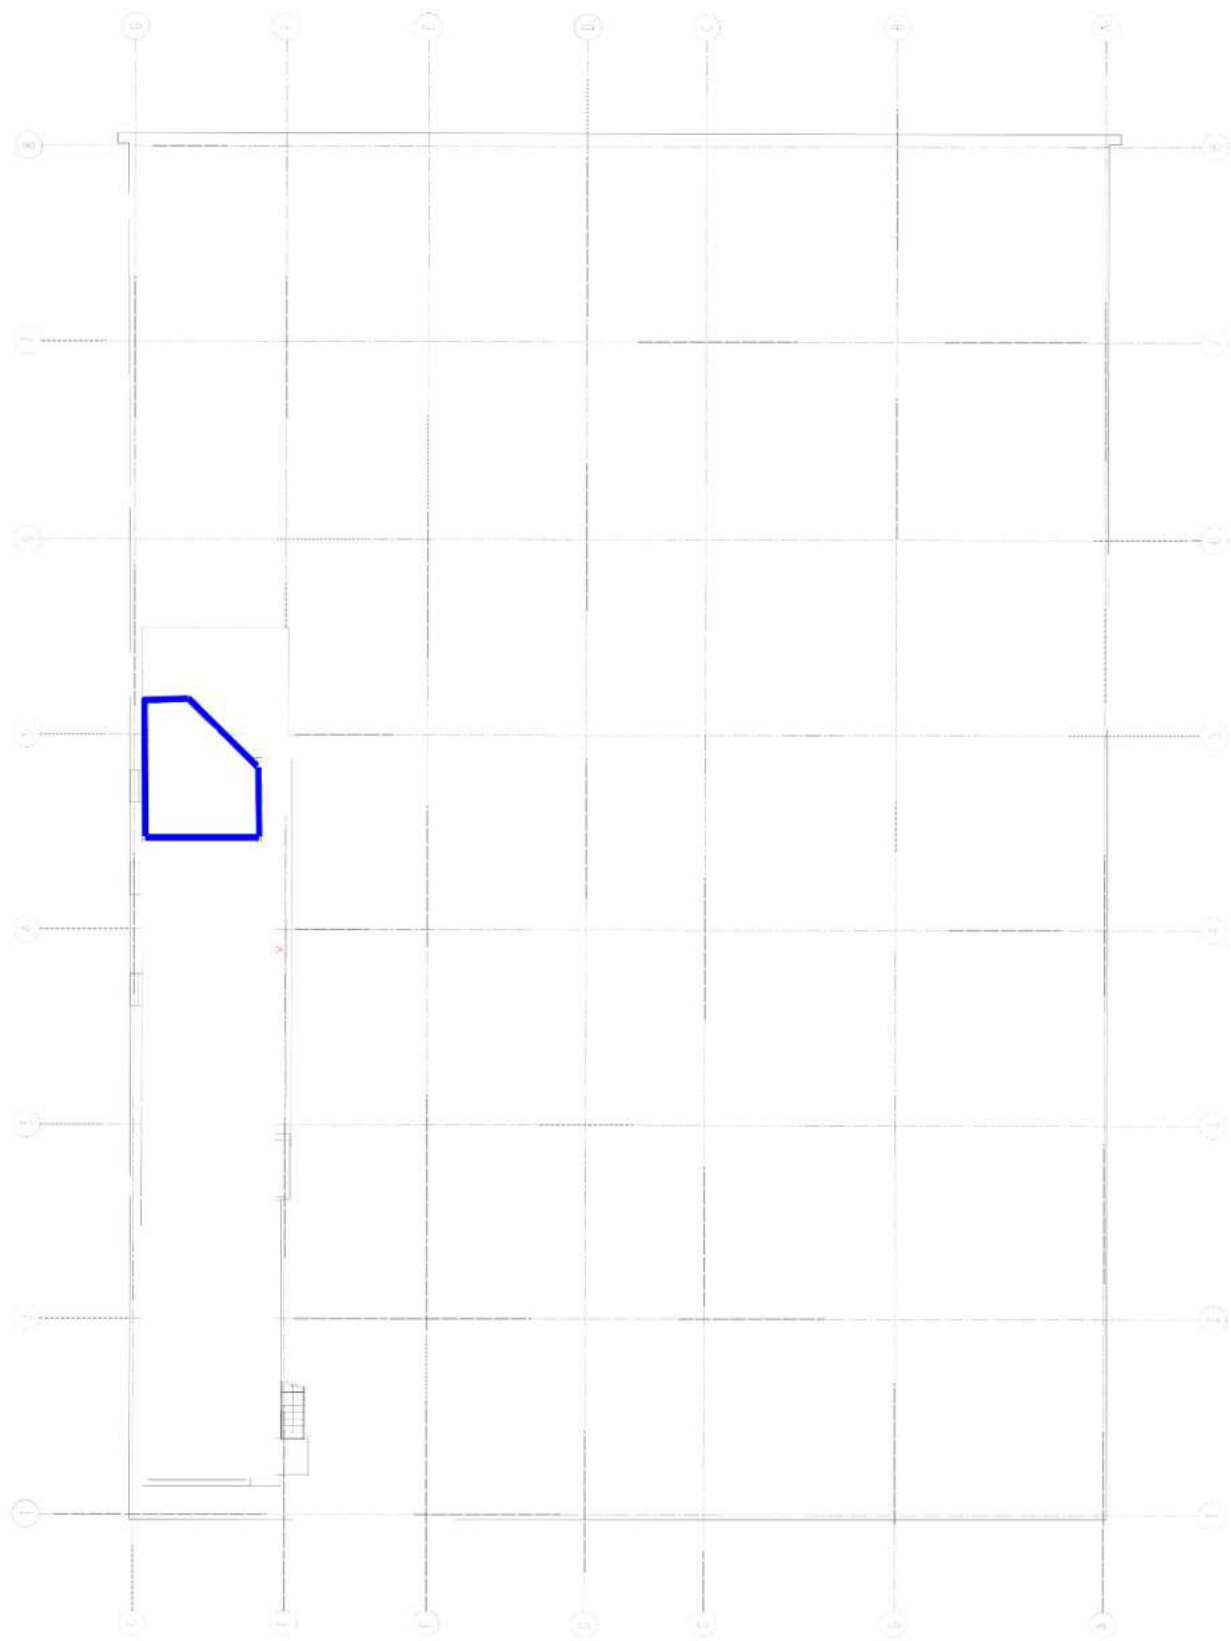


Plan 7

Jet Centre - Ground Floor

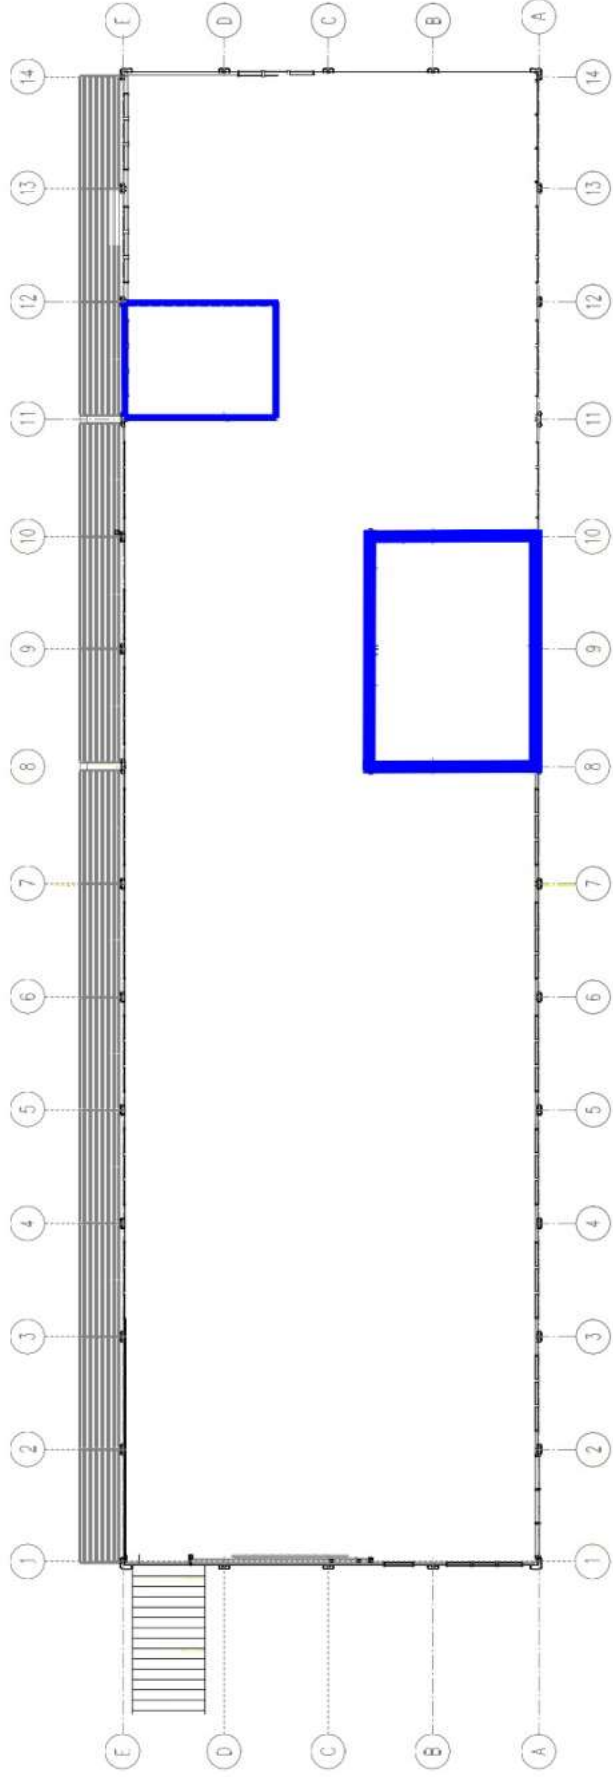

Jet Centre - First Floor

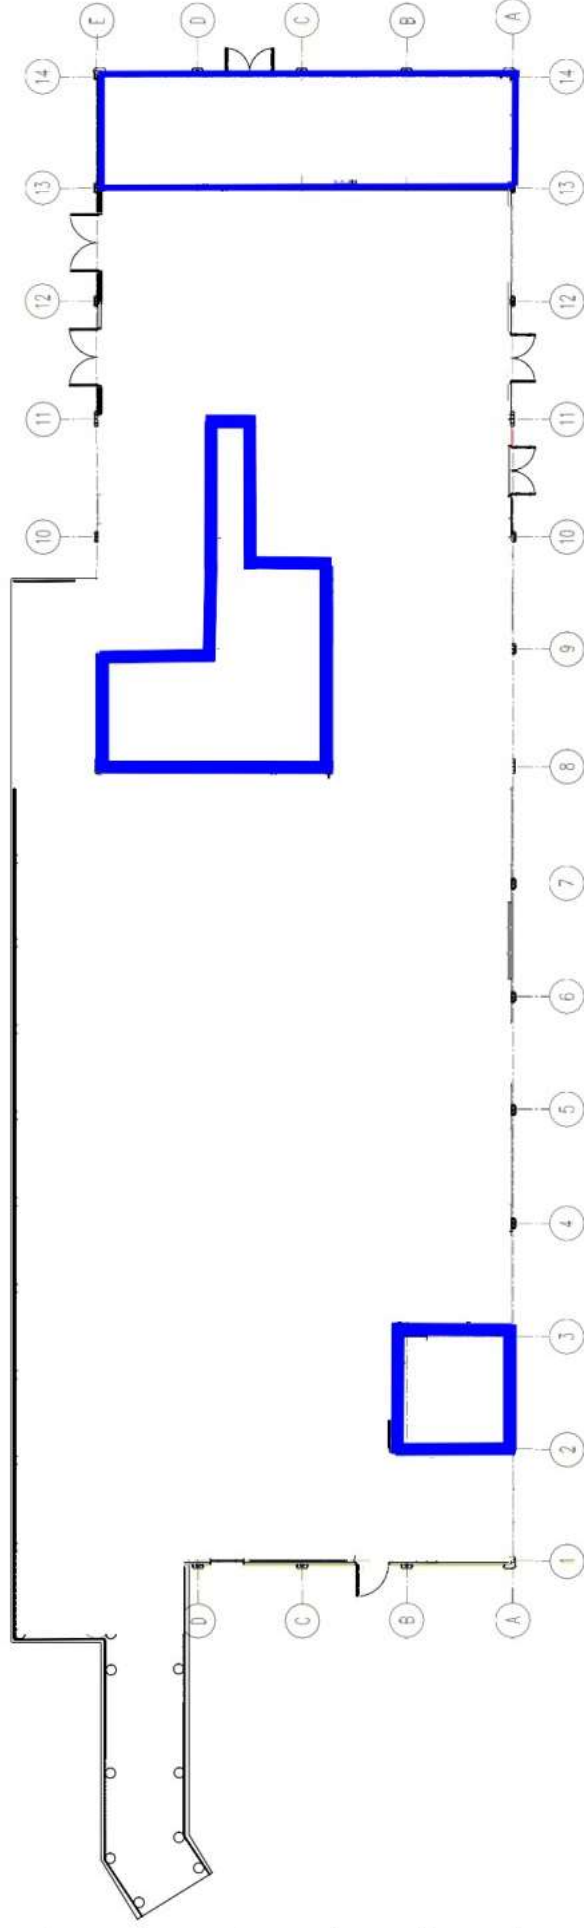

LEGEND

- XXX Fire Door
- XXX Standard Door

1	Room Number	1000/10
2	Room Name	1000/10
3	Room Type	1000/10
4	Room Area	1000/10
5	Room Volume	1000/10
6	Room Height	1000/10
7	Room Width	1000/10
8	Room Depth	1000/10
9	Room Length	1000/10

6-10

London City Airport
Jet Centre


RECORD DRAWING

JET CENTRE

Scale 1:100
SCA E 388 173 8 A1

RJC/A/001

City Aviation House

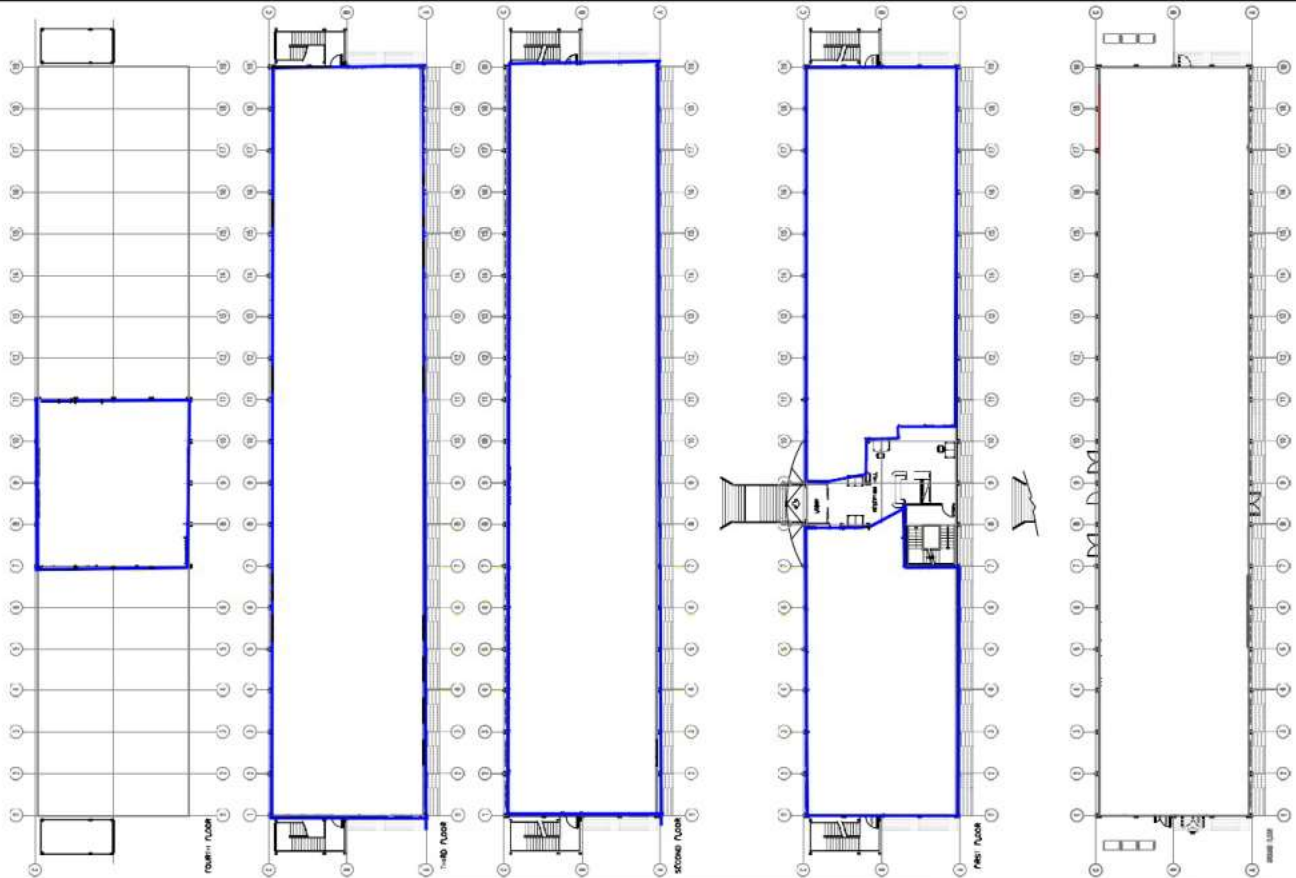

SCALE BAR 1:150 @ A1

1. Issue number - 001	01/01/19
2. Issue number - 002	02/01/19
3. Issue number - 003	03/01/19
4. Issue number - 004	04/01/19

24/03/19

LONDON CITY AIRPORT
LONDON CITY AIRPORT
RECORD DRAWING
CITY AVIATION HSE
R/CAH/A/A001

SCHEDULE 2 - UNDERTAKING GIVEN BY THE CLAIMANTS

- (1) The Claimants will take steps to notify Persons Unknown of the claim form, application notice, evidence in support, the Note of the Hearing on 20 June 2024, and the Order as soon as practicable and no later than 5pm on Monday 24 June 2024.
- (2) The Claimants will comply with any order for compensation which the Court might make in the event that the Court later finds that the injunction in paragraph 1 of this Order has caused loss to a future Defendant and the Court finds that the future Defendant ought to be compensated for that loss.

SCHEDULE 3 – EMAIL ADDRESSES

- juststopoil@protonmail.com
- juststopoilpress@protonmail.com
- info@juststopoil.org