



Claim Form

Re-amended pursuant to the order of the Honourable Mr Justice Soole dated 30 June 2026
You may be able to issue your claim online which may save time and money. Go to www.moneyclaims.service.gov.uk/make-claim to find out more.

In the High Court of Justice King's Bench Division											
Fee Account no.	PBA 0087211										
Help with Fees - Ref no. (if applicable)	<table><tr><td>H</td><td>W</td><td>F</td><td>-</td><td></td><td></td><td>-</td><td></td><td></td><td></td></tr></table>	H	W	F	-			-			
H	W	F	-			-					
For court use only											
Claim no.	KB-2024-001765										
Issue date											

Claimant(s) name(s) and address(es) including postcode

(1) London City Airport Limited of London City Airport, City Aviation House, Royal Docks, London E16 2PB
(2) Docklands Aviation Group Limited of City Aviation House, Royal Docks, London E16 2PB



Defendant(s) name and address(es) including postcode

Persons Unknown who, in connection with the Just Stop Oil or other environmental campaign or the Take Back Power campaign or other wealth inequality campaign, enter occupy or remain (without the Claimants' consent) upon that area of land known as London City Airport (as shown for identification edged red on the attached Plan 1) but excluding those areas of land as further defined below

Brief details of claim

The Claimants seek an injunction to restrain the Defendant from acts of trespass and/or nuisance on the land edged red on Plan 1 but excluding:-
(1) the land and buildings coloured blue on Plan 1;
(2) the defined areas coloured pink and purple on Plan 1; and
(3) those parts of buildings edged blue on the attached Plans 2-8.

The Claimants also seek costs and further and/or other relief

Value

This is a non-monetary claim

Defendant's
name and
address
for service
including
postcode

	£
Amount claimed	
Court fee	626.00
Legal representative's costs	TBC
Total amount	

Claim no.	
-----------	--

You must indicate your preferred County Court Hearing Centre for hearings here
(see notes for guidance)

King's Bench Division, The Royal Courts of Justice, Strand, London WC2A 2LL

Do you believe you, or a witness who will give evidence on your behalf, are vulnerable in any way which the court needs to consider?

- ☐ Yes. Please explain in what way you or the witness are vulnerable and what steps, support or adjustments you wish the court and the judge to consider.

- ☒ No

Does, or will, your claim include any issues under the Human Rights Act 1998?

- ☒ Yes
☐ No

Claim no.	
-----------	--

Particulars of Claim

☒ attached

☐ to follow

Statement of truth

Note: you are reminded that a copy of this claim form must be served on all other parties.

I understand that proceedings for contempt of court may be brought against a person who makes, or causes to be made, a false statement in a document verified by a statement of truth without an honest belief in its truth.

- ☐ **I believe** that the facts stated in this claim form and any attached sheets are true.
- ☒ **The claimant** believes that the facts stated in this claim form and any attached sheets are true. **I am authorised** by the claimant to sign this statement.

Signature



- ☐ Claimant
- ☐ Litigation friend (where claimant is a child or protected party)
- ☒ Claimant's legal representative (as defined by CPR 2.3(1))

Date

Day

7

Month

July

Year

2026

Full name

Alexander James Wright

Name of claimant's legal representative's firm

Eversheds Sutherland (Intl) LLP

If signing on behalf of firm or company give position or office held

Legal Director

Claimant's or claimant's legal representative's address to which documents should be sent.

Building and street

Two New Bailey, 6 Stanley Street

Second line of address

Town or city

Salford

County (optional)

Postcode

M	3		5	G	X		
---	---	--	---	---	---	--	--

If applicable

Phone number

020 7497 9797

DX number

DX 14344 Manchester

Your Ref.

WRIGHTAX/292659.000057

Email



Plan A

- TGL469846
- EGL5277797
- EGL5277799
- TGL617976
- EGL555153
- EGL519692
- EGL552140
- EGL518399
- TGL530134
- TGL338199
- EGL291578
- EGL465048
- EGL373364
- Albert Island


Map scale 1:5,650

Assumes printed map area measures 395mm by 272mm.

ORBITAL WITNESS

Amended pursuant to the Order of Bourne J dated 24 June 2026
Plan 1

- Injunction
- Excluded areas
- Part excluded areas
- Subsoil structures excluded
- DLR viaduct excluded

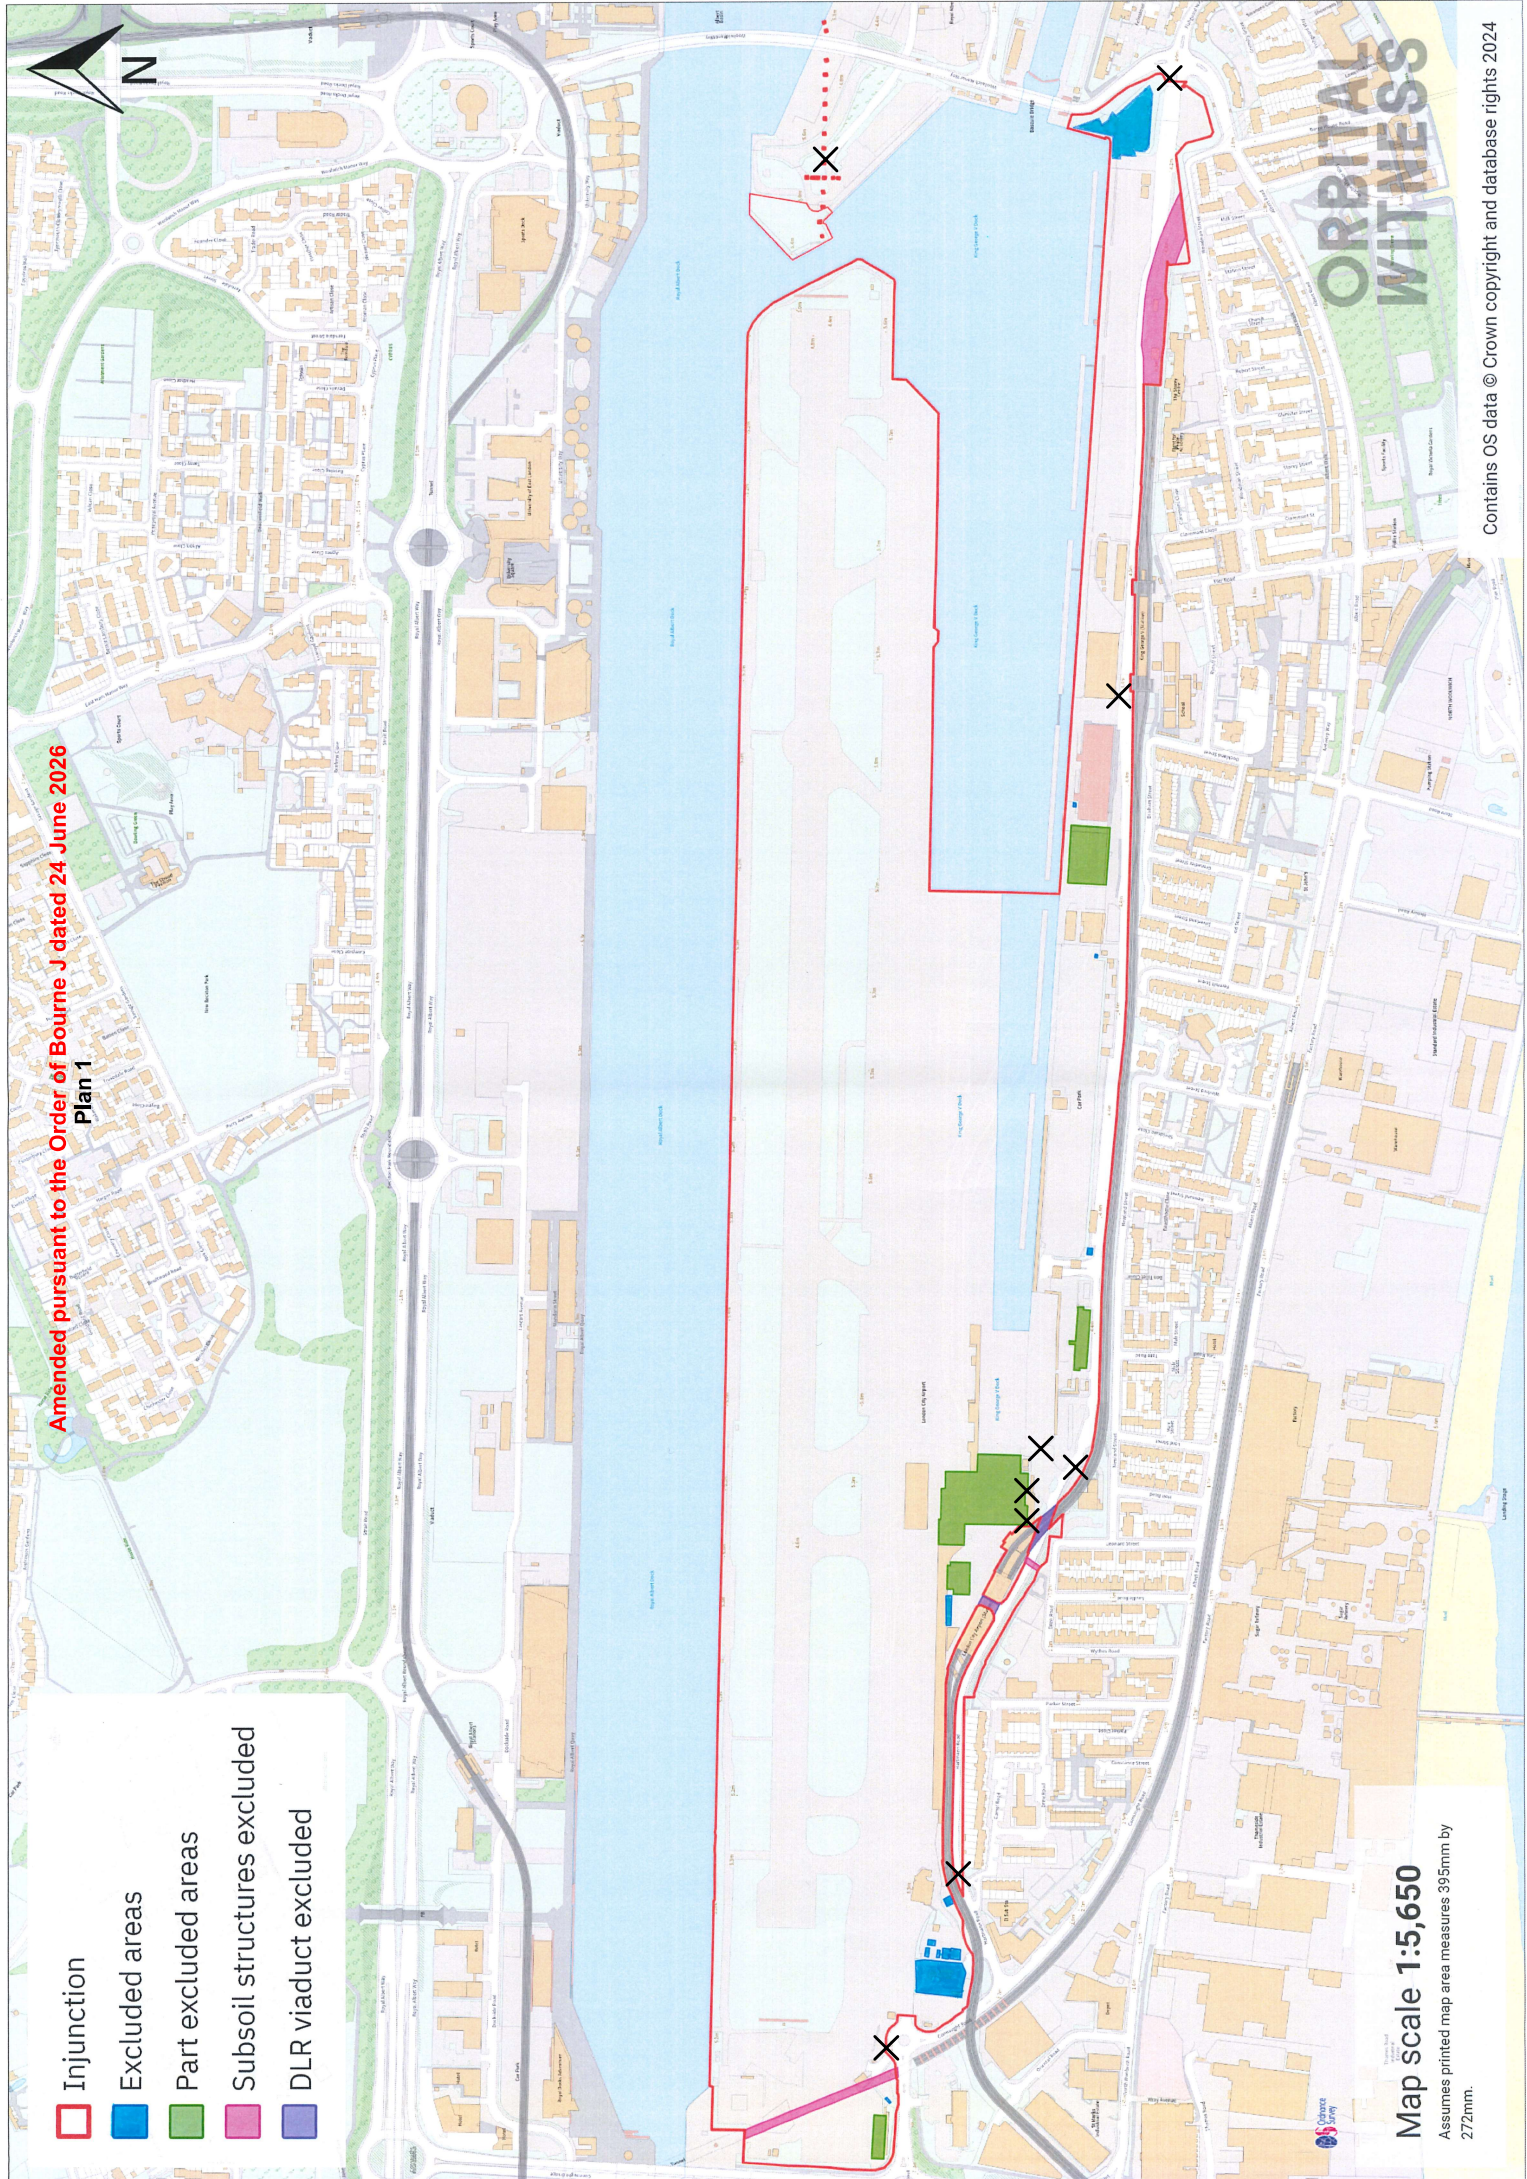


Map scale 1:5,650

Assumes printed map area measures 395mm by 272mm.


ORBITAL
WITNESS


Plan 2

Main Terminal - Ground Floor

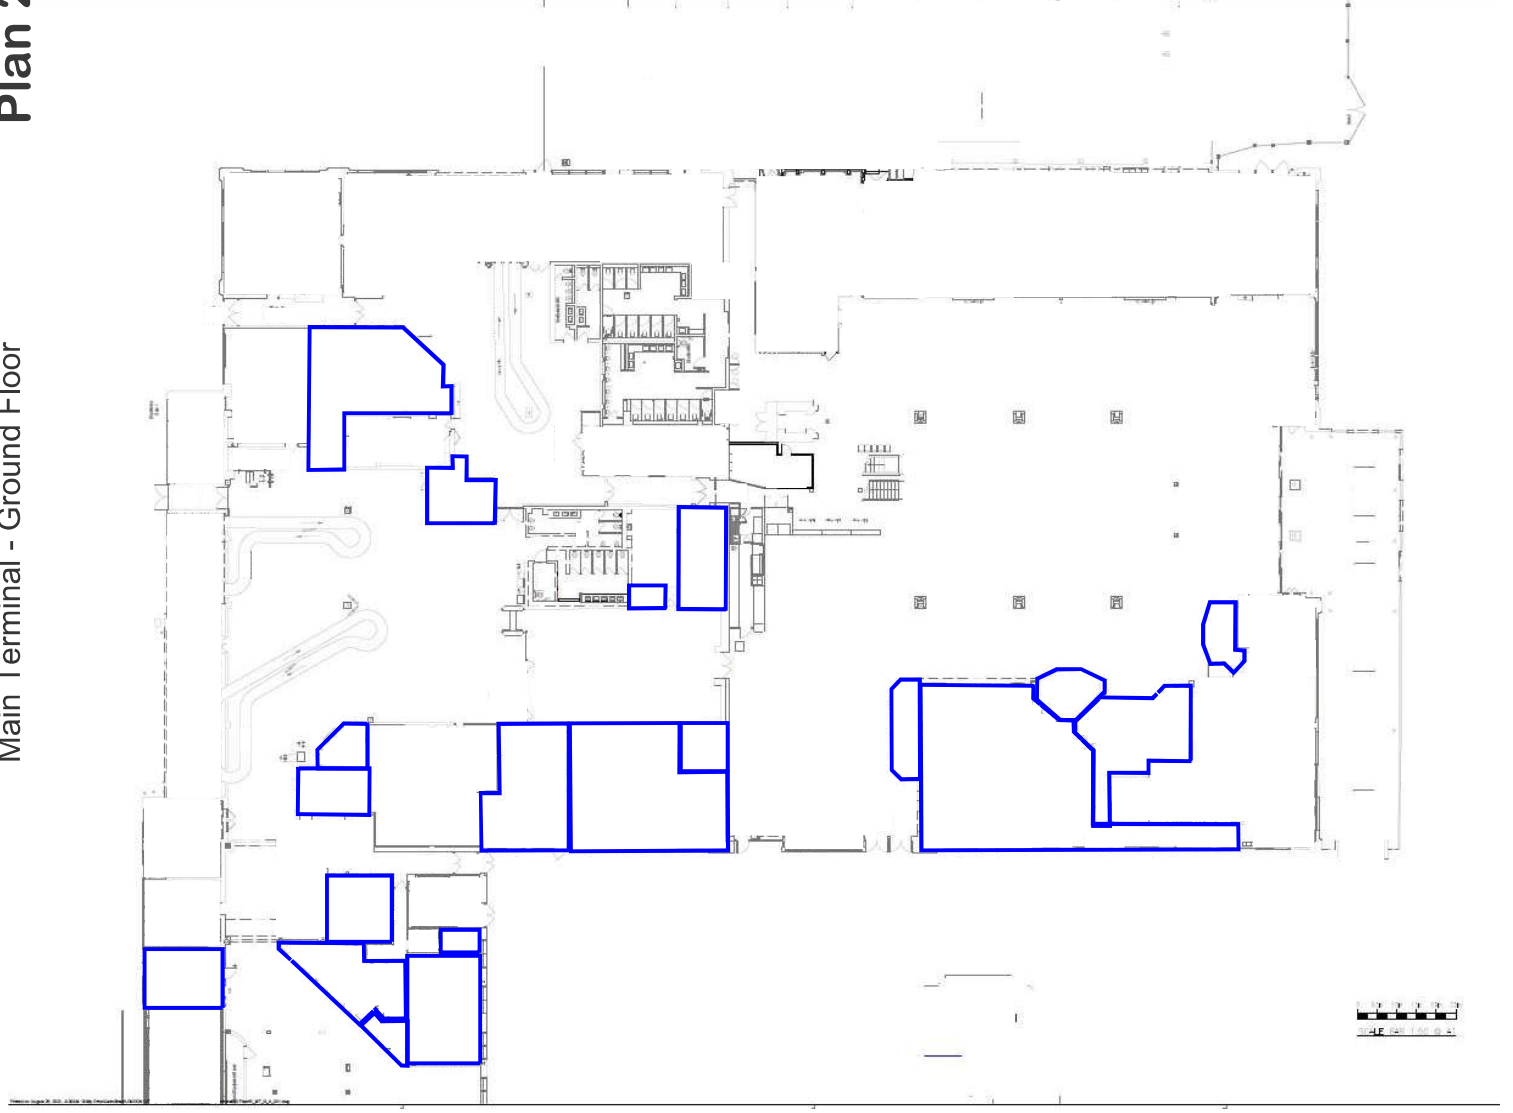

Plan 3

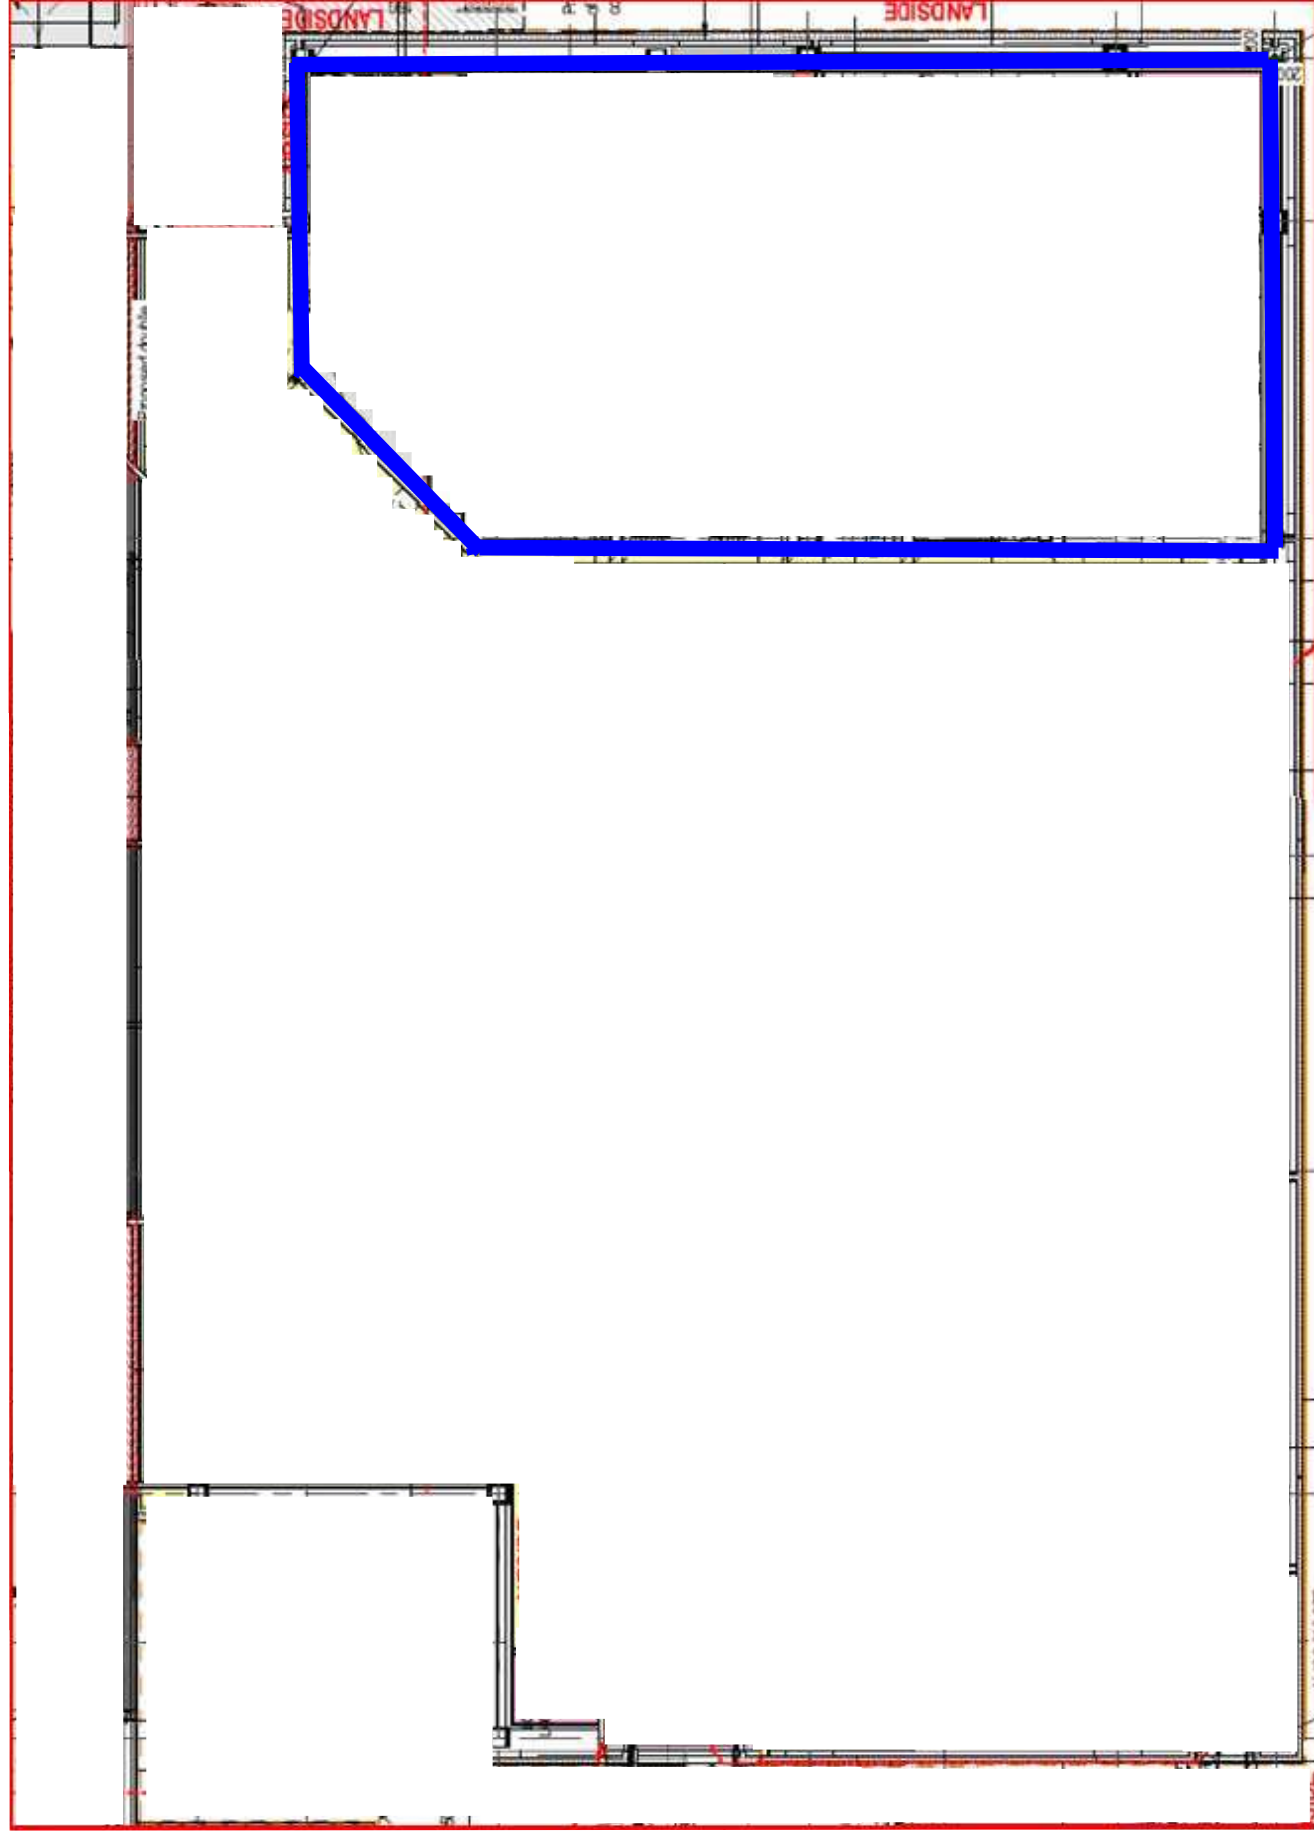


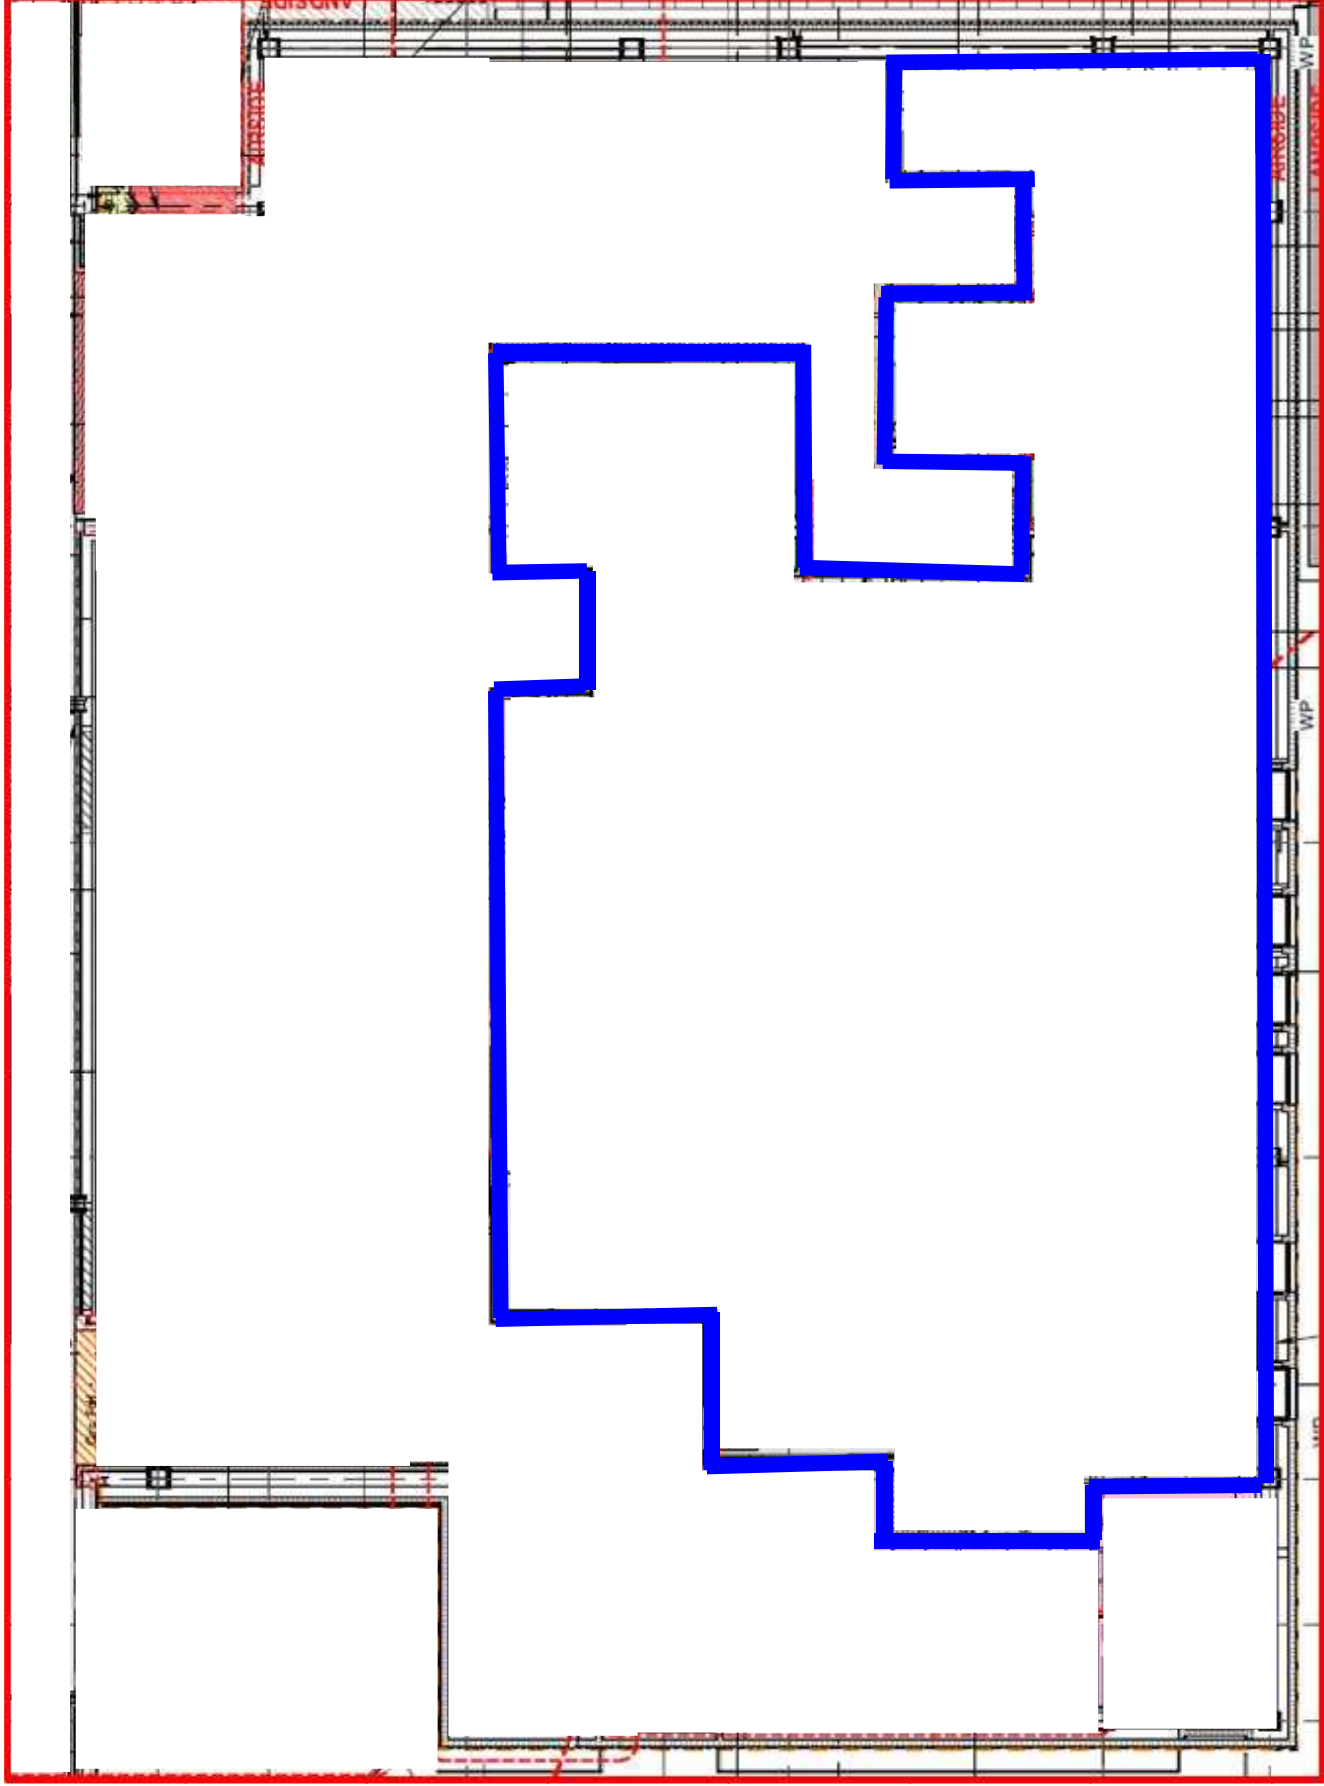

Blue Shed - Ground Floor

Plan 5

General Notes:

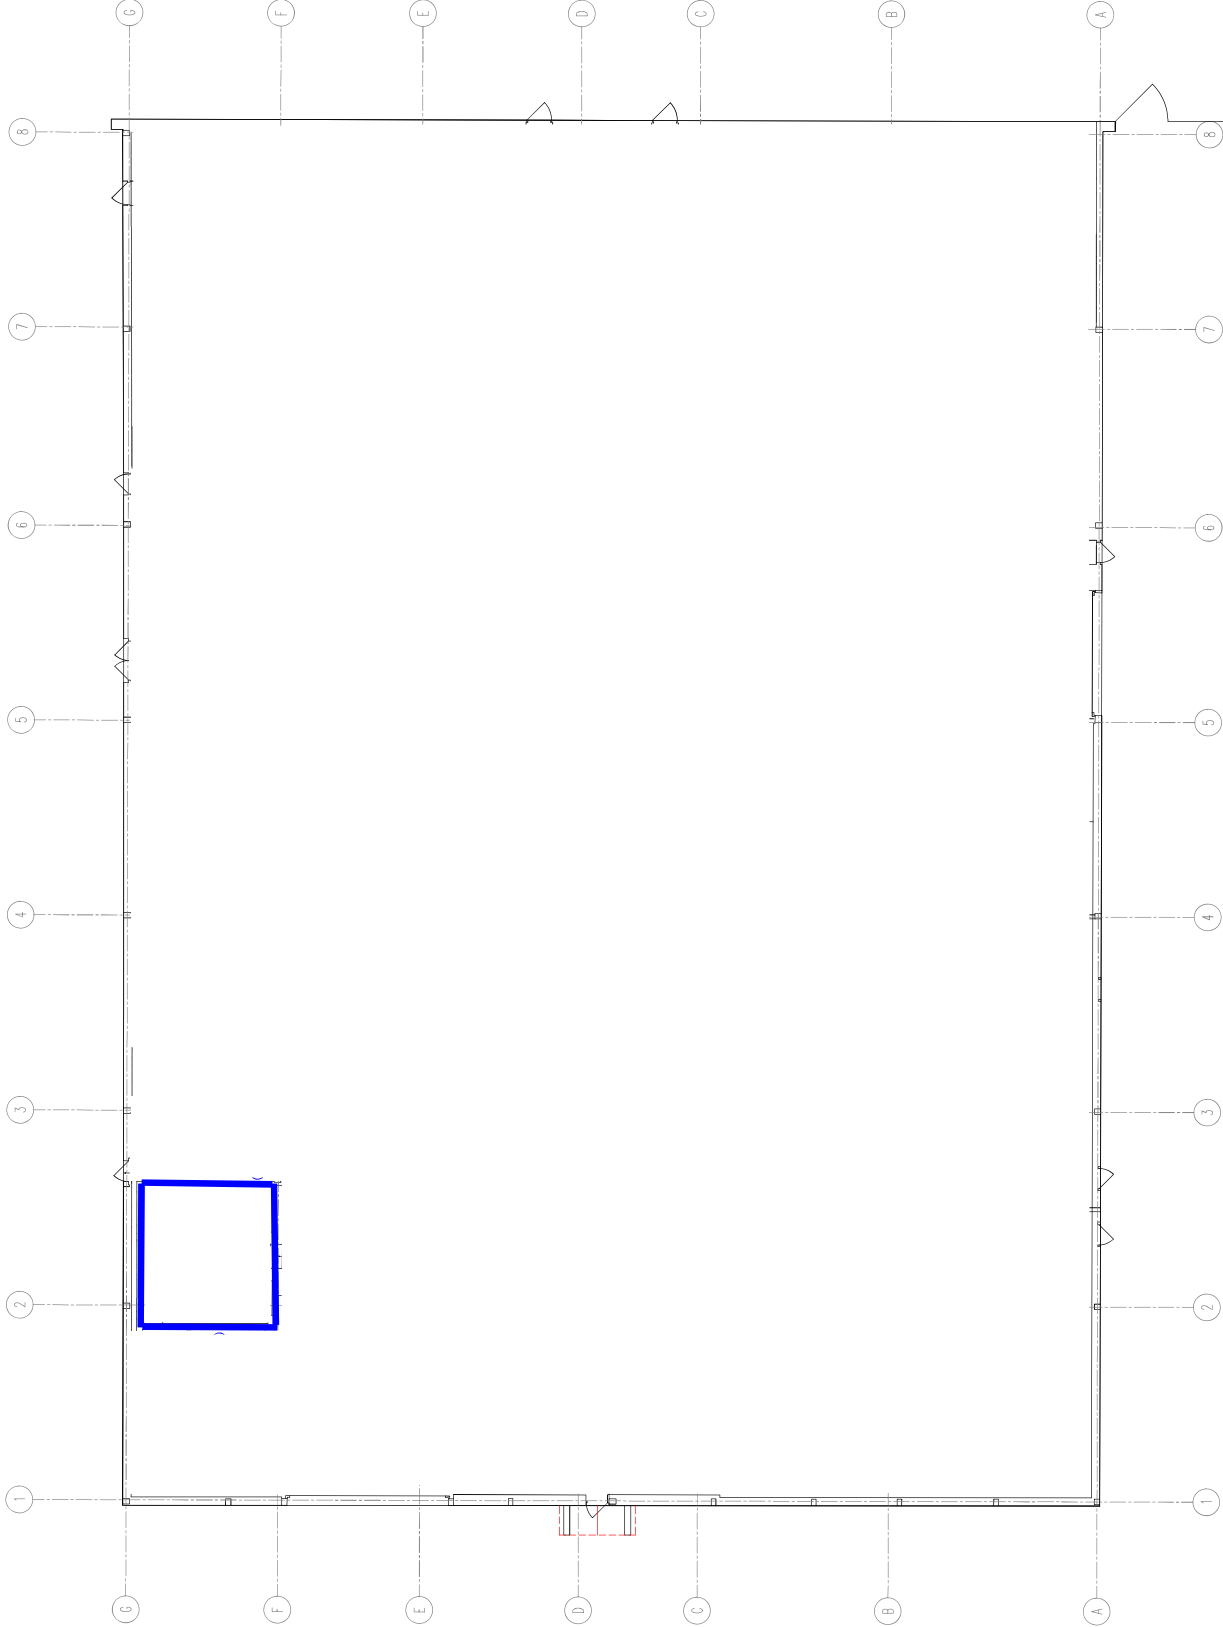

B	Door Schedule	2/17/18
A	Door Schedule	2/17/18



London City Airport, City Aviation House
Royal Dock, London, E16 3PB

RECORD DRAWING

BLUE SHED

Ground Floor

Ground Floor

Jet Centre - Ground Floor

Plan 7

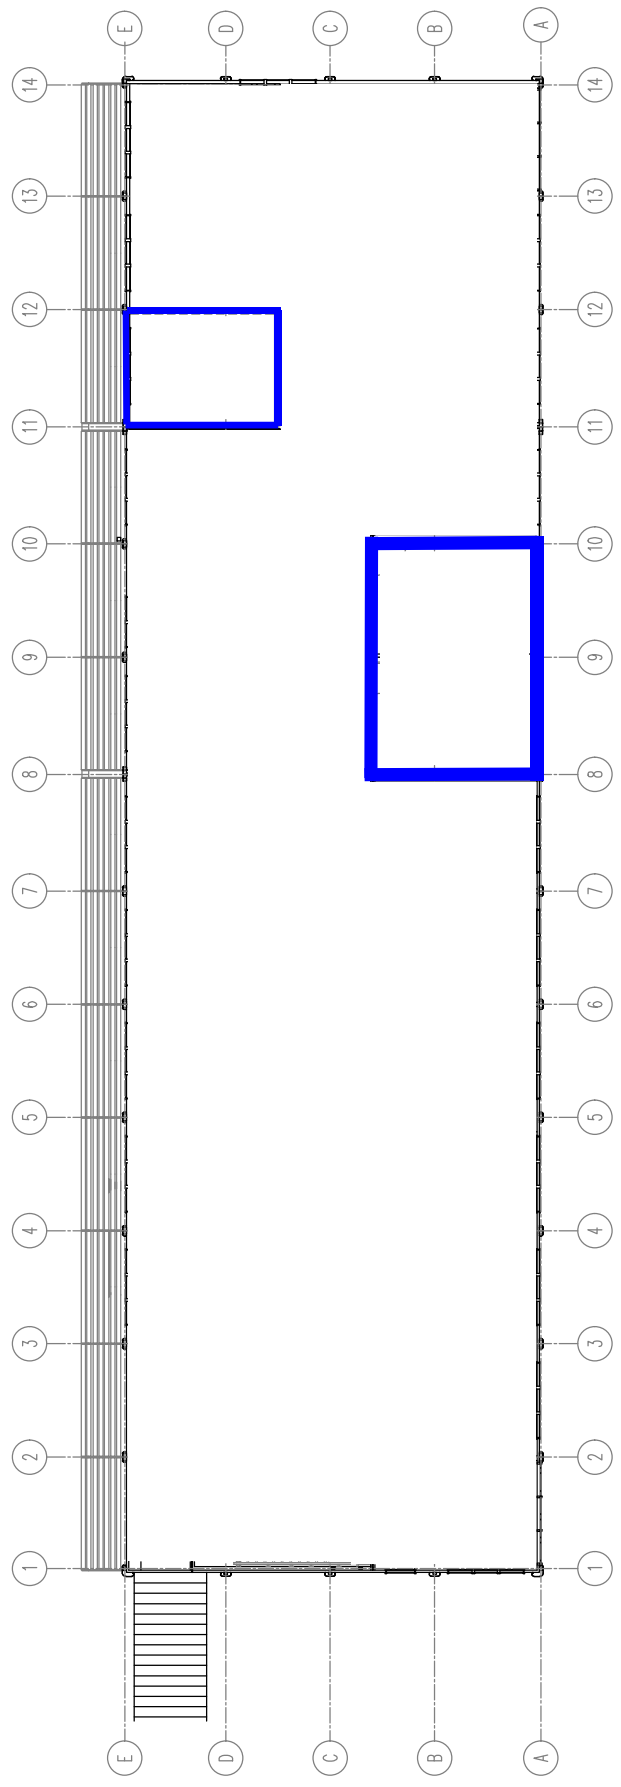

- General Notes
- LEGEND
- Fire Door
 - Standard Door

Jet Centre - First Floor

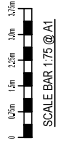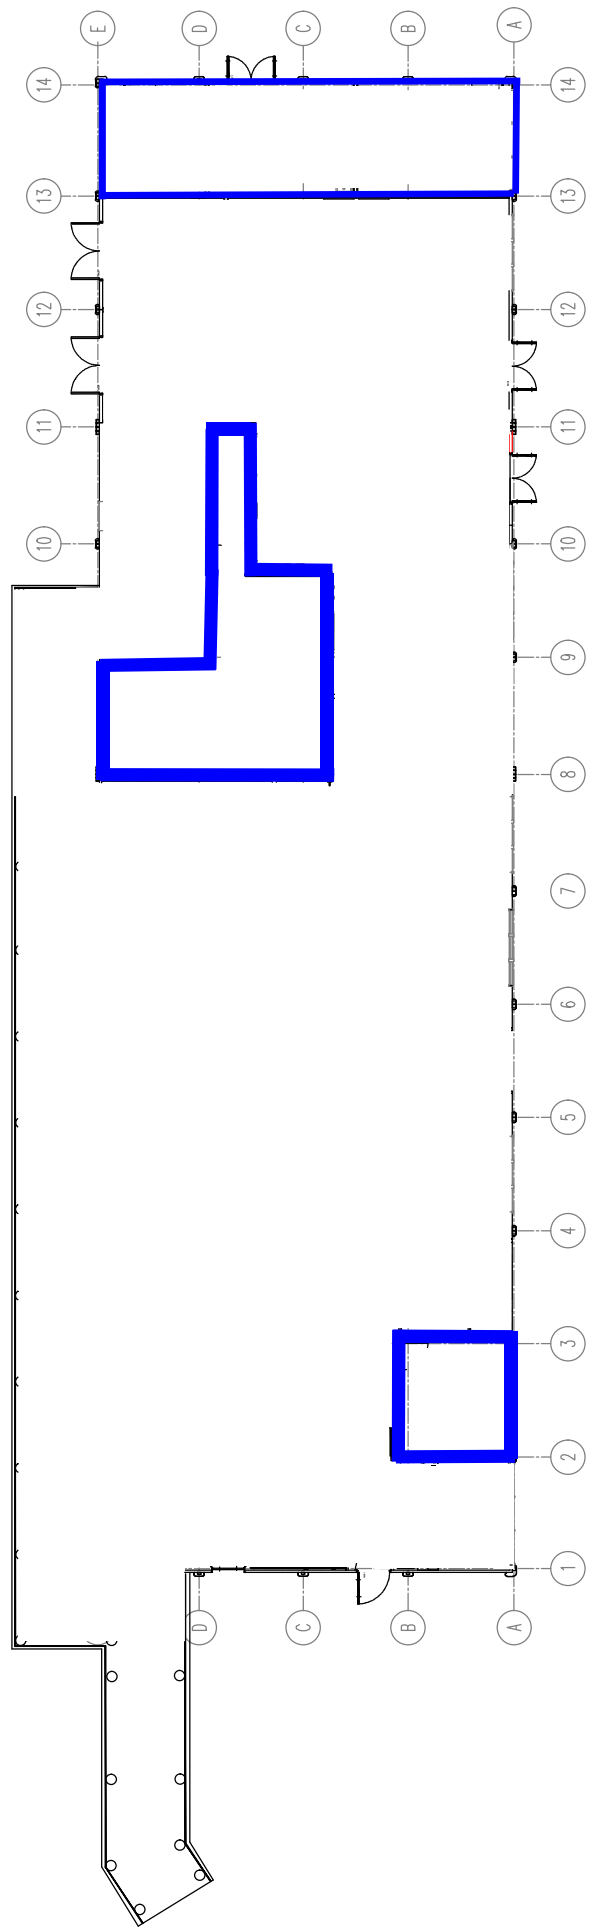

E	Room Number	Room Name
A	100/101	100/101
B	100/102	100/102
C	100/103	100/103
D	100/104	100/104
E	100/105	100/105

G+PERS

London City Airport
Get closer

RECORD DRAWING

JET CENTRE

Ground Floor Plan

General Arrangement Plan


20/07/15

RUC/AIA/001

1/75

Plan 8

City Aviation House

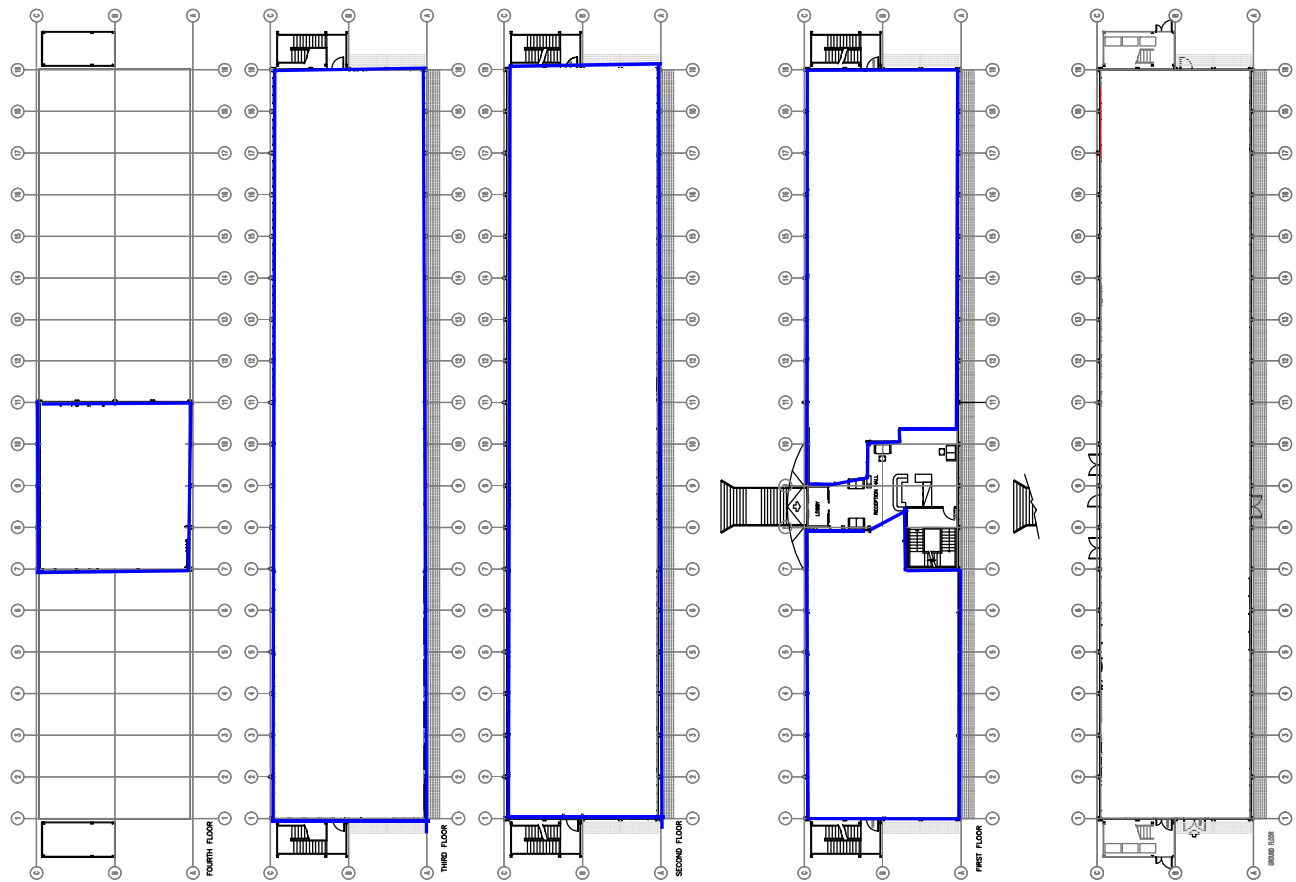

0 10m 20m 30m 40m 50m 60m 70m
SCALE BAR 1:150 @ A1

DO NOT SCALE - IF IN DOUBT ASK
Associated Drawings

General Notes

1	Legend omitted - See Plan	01/01/20
2	Legend omitted - See Plan	01/01/20
3	Legend omitted - See Plan	01/01/20
4	Legend omitted - See Plan	01/01/20

64185

LONDON CITY AIRPORT

London City Airport, City Aviation House
Plot 1000, London, UK 100

RECORD DRAWING

CITY AVIATION HSE

01/01/20

R/CAH/A/A001 D

1:150